

Must be approved by the K.C.C. five (5) days prior to commencing well

Expected Spud Date: 02/06/91 N/2 NE NE NW Sec 33 Twp 17 S Rg 27 East West
month day year

OPERATOR: License # 9041 ✓ 4950 feet from South Line of Section
3300 feet from East Line of Section ✓
(Note: Locate well on Section Plat on Reverse Side)

Name: JOSEPH H. STRABALA
Address: 312 E. UINTAH ST.
City/State/Zip: COLORADO SPRINGS CO 80903
Contact Person: JOE STRABALA
Phone: (303) 635-7807

County: LANE
Lease Name: L.J. SPANTIER Well# #1
Field Name: UNKNOWN

CONTRACTOR: License # 4083 ✓
Name: WESTERN KANSAS DRILLING

Is this a Prorated Field? yes no
Target Formation(s): LANSING
Nearest lease or unit boundary: 330
Ground Surface Elevation: 2665 feet MSL ✓
Domestic well within 330 feet: yes no
Municipal well within one mile: yes no
Depth to bottom of fresh water: 180
Depth to bottom of usable water: 1300
Surface Pipe by Alternate: 1 2
Length of Surface Pipe Planned to be set: 250
Length of Conductor Pipe required: *****
Projected Total Depth: 4700
Formation at Total Depth: MISSISSIPPI
Water Source for Drilling Operations:
well farm pond other
DWR Permit# _____
Directional, Deviated or Horizontal Wellbore? yes no Will Cores Be Taken? yes no
If yes, total depth location: _____ If yes, proposed zone: _____

Well Drilled For: Well Class: Type Equipment:
XX Oil Inj Infield XX Mud Rotary
Gas Storage Pool Ext Air Rotary
OWWO Disposal XX Wildcat Cable
Seismic; # of Holes

If OWWO; old well information as follows:
Operator: _____
Well Name: _____
Comp Date: _____ Old Total Depth: _____

AFFIDAVIT

The undersigned hereby affirms that the drilling, completion and eventual plugging of this well will comply with K.S.A. 55-101, et. seq.

- It is agreed that the following minimum requirements will be met:
1. The appropriate district office shall be notified before setting surface pipe;
 2. The minimum amount of surface pipe as specified above shall be set by circulating cement to the top; in all cases surface pipe shall be set through all unconsolidated materials plus a minimum of 20 feet into the underlying formation;
 3. If the well is dry, a plugging proposal shall be submitted to the district office. An agreement between the operator and the district office on plug length and placement is necessary prior to plugging;
 4. The appropriate district office will be notified before well is either plugged or production casing is cemented in;
 5. If an Alternate II completion, production pipe shall be cemented from below any usable water to surface within 120 days of spud date. In all cases, notify district office prior to any cementing.

I hereby certify that the statements made herein are true and to the best of my knowledge and belief.
Date: 01/28/91 Signature of Operator or Agent: [Signature] Title: AS AGENT

FOR KCC USE:
API # 15- 101-21568-00-00
Conductor Pipe Required None feet
Minimum surface pipe required 200 feet per Alt. X @
Approved by: [Signature] 1-28-91
EFFECTIVE DATE: 2-3-91
This authorization expires: 7-28-91
(This authorization void if drilling not started within 6 months of effective date.)
Spud date: _____ Agent: _____

REMEMBER TO:

- File Drill Pit Application (form CDP-1) with Intent to Drill;
- File Completion Form ACO-1 within 120 days of spud date;
- File acreage attribution plat according to field prorations orders;
- Notify appropriate district office 48 hours prior to workover or re-entry;
- Submit plugging report (CP-4) after plugging is completed;
- Obtain written approval before disposing or injecting salt water.

WICHITA, KANSAS
JAN 28 1991
33
[Handwritten notes and stamps]


PLAT OF ACREAGE ATTRIBUTABLE TO A WELL

State Corporation Commission, Conservation Division
200 Colorado Derby Bldg. Wichita, Kansas 67202

OPERATOR JOSEPH H. STRABALA LOCATION OF WELL:
 LEASE L.I. SPANIER 4950 feet north of SE corner
 WELL NUMBER #1 3300 feet west of SE corner
 FIELD UNKNOWN NW Sec. 33 T 17 R 27 *(NW)*
 COUNTY LANE
 NO. OF ACRES ATTRIBUTABLE TO WELL _____ IS SECTION REGULAR IRREGULAR?
 DESCRIPTION OF ACREAGE NW IF IRREGULAR, LOCATE WELL FROM NEAREST
 CORNER BOUNDARY.

NOTE: If plat depicted is insufficient for your circumstances, you may attach your own scaled or surveyed plat.

*non-prorated field

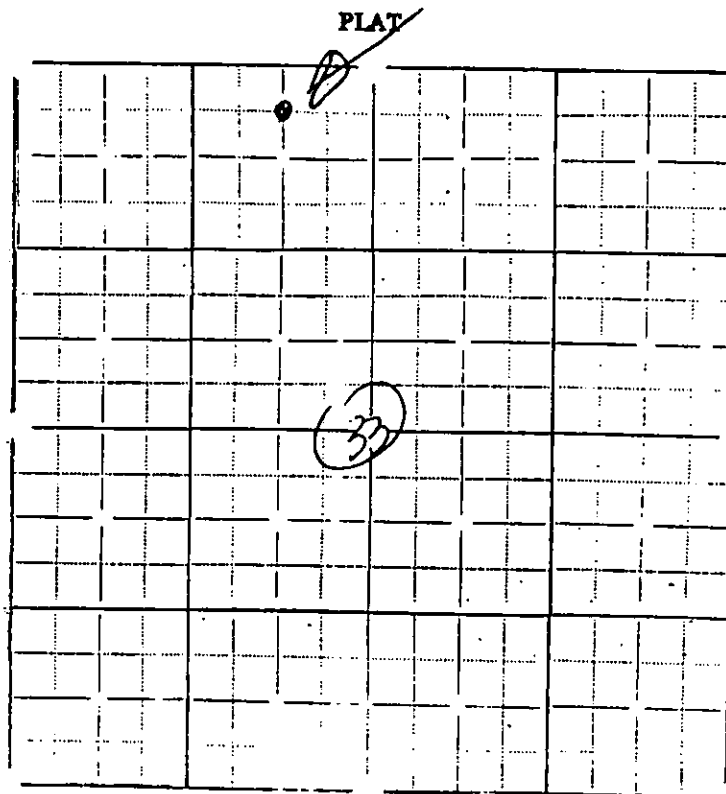

In plotting the proposed location of the well, you must show:

- 1) The manner in which you are using the depicted plat by identifying section lines, i.e. 1 section, 1 section with 8 surrounding partial sections, 4 sections, 16 sections, etc.;
- 2) the well's location relative to the location of other wells producing from the same common source of supply in adjoining drilling units, pursuant to K.A.R. 82-3-108, 82-3-207, 82-3-312, or special orders of the Commission;
- 3) the distance of the proposed drilling location from the section's east and south lines; and
- 4) the distance to the nearest lease or unit boundary line.

I hereby certify that the statements made herein are true and to the best of my knowledge and belief.

Signature of Operator or Agent *J. Strabala*
 Title SEARCH, INC.

Date 01/28/91