

CARD MUST BE TYPED

State of Kansas

CARD MUST BE SIGNED

NOTICE OF INTENTION TO DRILL

(see rules on reverse side)

Starting Date April 7 1987
month day year 8, 22

API Number 15-101-21,376-00-00 ✓

OPERATOR: License # 9482

NW NE NE Sec. 35 Twp. 16 S, Rg. 29 ~~XX~~ West

Name NATIONAL PETROLEUM RESERVES, INC.

Address 260 N. Rock Rd., Ste. 215

City/State/Zip Wichita, KS. 67206

Contact Person Ted C. Bredehoft

Phone (316) 681-3515

..... 4950 Ft. from South Line of Section

..... 990 Ft. from East Line of Section

(Note: Locate well on Section Plat on reverse side)

Nearest lease or unit boundary line 330 feet

County LANE

Lease Name GILL Well # 2

Ground surface elevation feet MSL

Domestic well within 330 feet: yes no

Municipal well within one mile: yes no

Depth to bottom of fresh water 90

Depth to bottom of usable water 1475

Surface pipe by Alternate: 1 2 XX

Surface pipe planned to be set 200 ft.

Conductor pipe required

Projected Total Depth 4,600 ft feet

Formation Marmaton, Ft. Scott, Cherokee, Lansing

CONTRACTOR: License #

Name (undetermined)

City/State

Well Drilled For: Well Class: Type Equipment:

XX Oil SWD Infield XX Mud Rotary

..... Gas Inj XX Pool Ext. Air Rotary

..... OWWO Expl Wildcat Cable

If OWWO: old well info as follows:

Operator

Well Name

Comp Date Old Total Depth

I certify that well will comply with K.S.A. 55-101, et seq., plus eventually plugging hole to KCC specifications.

Date 4-6-87 Signature of Operator or Agent *Ted C. Bredehoft* Title President

For KCC Use:

Conductor Pipe Required feet; Minimum Surface Pipe Required 200 feet per AM 90

This Authorization Expires 10-6-87 Approved By 4-6-87


Eastman

Must be filed with the K.C.C. five (5) days prior to commencing well
This card void if drilling not started within six (6) months of date received by K.C.C.

Important procedures to follow:

1. Notify District office before setting surface casing.
2. Set surface casing by circulating cement to the top.
3. File completion forms ACO-1 with K.C.C. within 90 days of well completion, following instructions on ACO-1, side 1, and including copies of wireline logs.
4. Notify District office 48 hours prior to old well workover or re-entry.
5. Prior to filing Intent, prepare a proposed plugging plan in case well is D & A, then obtain approval of plan when calling district office prior to setting surface pipe.
6. Submit plugging report (CP-4) to K.C.C. after plugging is completed.
7. Obtain an approved injection docket number before disposing of salt water.
8. Notify K.C.C. within 10 days when injection commences or terminates.
9. If an alternate 2 completion, cement in the production pipe from below any usable water to surface within 120 days of spud date.

A Regular Section of Land
1 Mile = 5,280 Ft.

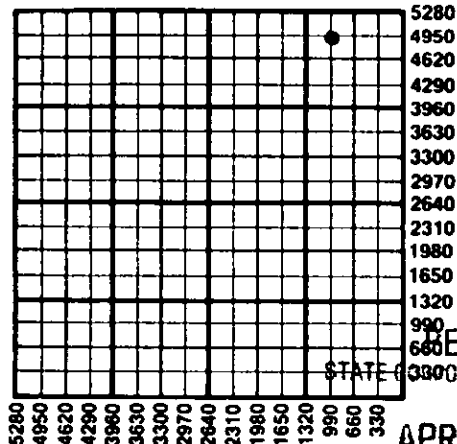

RECEIVED
APR 6 1987
04-06-1987
CONSERVATION DIVISION
Wichita, Kansas

State Corporation Commission of Kansas
Conservation Division
200 Colorado Derby Building
Wichita, Kansas 67202
(316) 263-3238