

CARD MUST BE TYPED

State of Kansas

CARD MUST BE SIGNED

DA

# NOTICE OF INTENTION TO DRILL

(see rules on reverse side)

Expected Spud Date: November 20 1987  
month day year

API Number 15-101-21,439-00-00

OPERATOR: License # 9482  
Name National Petroleum Reserves, Inc.  
Address 260 N. Rock Rd., Ste. 215  
City/State/Zip Wichita, KS. 67206  
Contact Person Ted c. Bredehoft  
Phone (316) 681-3515

SW SW NW Sec. 35 Twp. 16 S. Rg. 29 XX East West  
2,970 Ft. from South Line of Section  
4,950 Ft. from East Line of Section

(Note: Locate well on Section Plat on reverse side)

CONTRACTOR: License # 5302  
Name Red Tiger Drilling Co., Inc.  
City/State Wichita, Ks.

Nearest lease or unit boundary line 330 feet  
County Lane  
Lease Name GILL 'B' Well # 1

Well Drilled For: Well Class: Type Equipment:  
 Oil  Storage  Infield  Mud Rotary  
 Gas  Inj  Pool Ext.  Air Rotary  
 OWWO  Expl  Wildcat  Cable

Ground surface elevation 200 feet MSL  
Domestic well within 330 feet:  yes  no  
Municipal well within one mile:  yes  no  
Depth to bottom of fresh water 300  
Depth to bottom of usable water 300  
Surface pipe by Alternate: 1 2 XX

If OWWO: old well info as follows:

Operator .....  
Well Name .....  
Comp Date ..... Old Total Depth .....

Surface pipe planned to be set 250 ft.  
Conductor pipe required .....  
Projected Total Depth 4,600 feet  
Formation Lansing, KC, Marmaton, Altamont, Ft. Scott, Mississippian

I certify that well will comply with K.S.A. 55-101, et seq., plus eventually plugging hole to KCC specifications.

Date 11-10-87 Signature of Operator or Agent [Signature] Title Pres/Treas.

For KCC Use:

Conductor Pipe Required ..... feet; Minimum Surface Pipe Required 250 feet per Alt [Signature]

This Authorization Expires 5-12-88 Approved By [Signature] 11-12-87


EFFECTIVE DATE: 11-17-87

Must be filed with the K.C.C. five (5) days prior to commencing well  
This card void if drilling not started within six (6) months of date received by K.C.C.

Important procedures to follow:

1. Notify District office before setting surface casing.
2. Set surface casing by circulating cement to the top.
3. File completion forms ACO-1 with K.C.C. within 120 days of well spud date, following instructions on ACO-1, side 1, and including copies of wireline logs.
4. Notify District office 48 hours prior to old well workover or re-entry.
5. Prior to filing Intent, prepare a proposed plugging plan in case well is D & A, then obtain approval of plan when calling district office prior to setting surface pipe.
6. Submit plugging report (CP-4) to K.C.C. after plugging is completed.
7. Obtain an approved injection docket number before disposing of salt water.
8. Notify K.C.C. within 10 days when injection commences or terminates.

A Regular Section of Land  
1 Mile = 5,280 Ft.

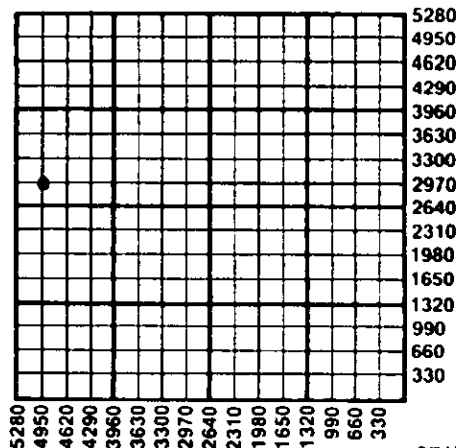

9. If an alternate 2 completion, cement in the production pipe from below any usable water to surface within 120 days of spud date.

NOV 12 1987  
11-12-1987  
CONSERVATION DIVISION  
Wichita, Kansas

State Corporation Commission of Kansas  
Conservation Division  
200 Colorado Derby Building  
Wichita, Kansas 67202-1212  
(316) 263-3238