

CARD MUST BE TYPED

State of Kansas

CARD MUST BE SIGNED

NOTICE OF INTENTION TO DRILL

(see rules on reverse side)

Expected Spud Date... October.....6.....1987.....
month day year

API Number 15- 101-21,426-00-00

OPERATOR: License #.....5181.....
Name.....SLAWSON, DONALD C......
Address.....200 Douglas Building.....
City/State/Zip.....Wichita, Kansas 67202.....
Contact Person...Bill Horigan.....
Phone.....(316) 263-3201.....

SE SW NE Sec. 7 Twp. 17S S. Rg. 27 East
.....2970'..... Ft. from South Line of Section
.....1640'..... Ft. from East Line of Section

(Note: Locate well on Section Plat on reverse side)

CONTRACTOR: License #.....5657.....
Name.....Slawson Drlg. Co......
City/State...Wichita, Kansas.....

Nearest lease or unit boundary line 330'..... feet
County..... Lane.....
Lease Name... HANKS 'R'..... Well # .. 2.....
Ground surface elevation ... 2722' GR (Seis)..... feet MSL

Well Drilled For: Well Class: Type Equipment:
X Oil Storage Infield X Mud Rotary
 Gas Inj Pool Ext. Air Rotary
 OWWO Expl X Wildcat Cable

Domestic well within 330 feet: yes no
Municipal well within one mile: yes no

If OWWO: old well info as follows:
Operator.....
Well Name.....
Comp Date..... Old Total Depth.....

Depth to bottom of fresh water..... 140'
Depth to bottom of usable water 1100' 1300 Base K
Surface pipe by Alternate: 1 X 2
Surface pipe planned to be set 240'
Conductor pipe required
Projected Total Depth 4650' feet
Formation..... MISSISSIPPIAN

I certify that well will comply with K.S.A. 55-101, et seq., plus eventually plugging hole to KCC specifications. Western Kansas
Date... 10/2/87..... Signature of Operator or Agent Scott A. Oatsdean..... Title..... Geologist


For KCC Use:
Conductor Pipe Required feet; Minimum Surface Pipe Required 200 feet per Alt. 002
This Authorization Expires 4-2-88..... Approved By FH102-87
EFFECTIVE DATE: 10-2-87

Must be filed with the K.C.C. five (5) days prior to commencing well
This card void if drilling not started within six (6) months of date received by K.C.C.

Important procedures to follow:

1. Notify District office before setting surface casing.
2. Set surface casing by circulating cement to the top.
3. File completion forms ACO-1 with K.C.C. within 120 days of well spud date, following instructions on ACO-1, side 1, and including copies of wireline logs.
4. Notify District office 48 hours prior to old well workover or re-entry.
5. Prior to filing Intent, prepare a proposed plugging plan in case well is D & A, then obtain approval of plan when calling district office prior to setting surface pipe.
6. Submit plugging report (CP-4) to K.C.C. after plugging is completed.
7. Obtain an approved injection docket number before disposing of salt water.
8. Notify K.C.C. within 10 days when injection commences or terminates.
9. If an alternate 2 completion, cement in the production pipe from below any usable water to surface within 120 days of spud date.

**A Regular Section of Land
1 Mile = 5,280 Ft.**

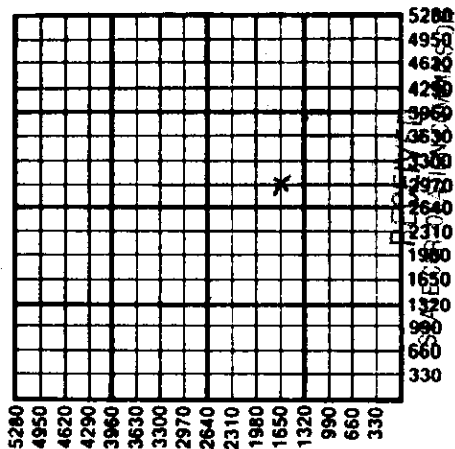

OCT 2 1987

CONSERVATION DIVISION
Wichita, Kansas

State Corporation Commission of Kansas
Conservation Division
200 Colorado Derby Building
Wichita, Kansas 67202-1212
(316) 263-3238