

NOTICE OF INTENTION TO DRILL

CORRECTION (LOCATION CHANGE) * X

Expected Spud Date... December 14 1987 (see rules on reverse side)

API Number 15-

101-21,444-00-00

OPERATOR: License # 5238
Name Petroleum, Inc.
Address 301 N. Main, Suite 900
City/State/Zip Wichita, KS 67202
Contact Person Terry Naylor
Phone 316 793-8471

Approx. NE NW SE Sec 6 Twp 18 S. Rg 28
2300' Ft. from South Line of Section
1530' Ft. from East Line of Section

(Note: Locate well on Section Plat on reverse side)

CONTRACTOR: License # 5104
Name Blue Goose Drilling Co., Inc.
City/State Box 1413, Gt. Bend, KS 67530

Nearest lease or unit boundary line 340 feet
County Lane

Lease Name Johnston 'C' Well # 1

Well Drilled For: Well Class: Type Equipment:
X Oil Storage Infield X Mud Rotary
Gas Inj Pool Ext Air Rotary
OWWO Expl X Wildcat Cable

Ground surface elevation feet MSL

Domestic well within 330 feet: yes X no

Municipal well within one mile: yes X no

Depth to bottom of fresh water 150 feet

Depth to bottom of usable water 1100'-1200'

Surface pipe by Alternate: 1 2 X

Surface pipe planned to be set 200'

Conductor pipe required

Projected Total Depth 4650' feet

Formation Mississippi

If OWWO: old well info as follows:

Operator
Well Name
Comp Date Old Total Depth

I certify that well will comply with K.S.A. 55-101, et seq., plus eventually plugging hole to KCC specifications.

Date 12-18-87 Signature of Operator or Agent Title District Landman

For KCC Use:

Conductor Pipe Required feet; Minimum Surface Pipe Required 200 feet per Alt. X (2)

This Authorization Expires 5-30-88 Approved By RCH 12-18-87

ORIG. REV'D 11-30-87


* WAS: 1650' FEL

Must be filed with the K.C.C. five (5) days prior to commencing well
This card void if drilling not started within six (6) months of date received by K.C.C.

Important procedures to follow:

1. Notify District office before setting surface casing.
2. Set surface casing by circulating cement to the top.
3. File completion forms ACO-1 with K.C.C. within 120 days of well spud date, following instructions on ACO-1, side 1, and including copies of wireline logs.
4. Notify District office 48 hours prior to old well workover or re-entry.
5. Prior to filing Intent, prepare a proposed plugging plan in case well is D & A, then obtain approval of plan when calling district office prior to setting surface pipe.
6. Submit plugging report (CP-4) to K.C.C. after plugging is completed.
7. Obtain an approved injection docket number before disposing of salt water.
8. Notify K.C.C. within 10 days when injection commences or terminates.

A Regular Section of Land
1 Mile = 5,280 Ft.

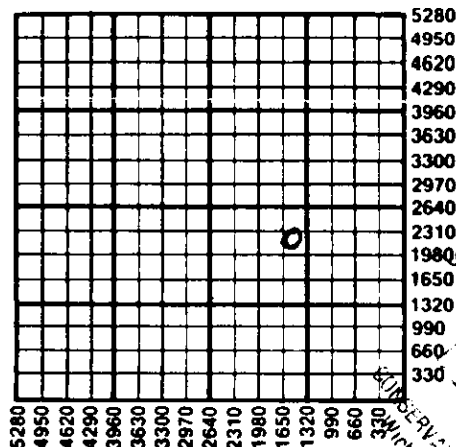

RECEIVED
1951 FEB 18 1951
CONSERVATION DIVISION
Wichita, Kansas

If an alternate 2 completion, cement in the production pipe from below any usable water to surface within 120 days of spud date.

State Corporation Commission of Kansas
Conservation Division
200 Colorado Derby Building
Wichita, Kansas 67202-1212
(316) 263-3238