

CARD MUST BE TYPED

State of Kansas

CARD MUST BE SIGNED

NOTICE OF INTENTION TO DRILL

(see rules on reverse side)

Expected Spud Date... May 18, 1987  
month day year

API Number 15- 101-21,387-00-00

OPERATOR: License # 3258  
Name LANSING ENERGY CORPORATION  
Address 204 South Terrace  
City/State/Zip Wichita, Kansas 67218  
Contact Person Richard L. Cornett  
Phone 316/684-1862

— East  
N/2 S/2 NE. Sec. 15... Twp. 16... S, Rg. 27... X West  
3630 Ft. from South Line of Section  
1320 Ft. from East Line of Section

(Note: Locate well on Section Plat on reverse side)

CONTRACTOR: License # 5864  
Name LOBO DRILLING COMPANY  
City/State Great Bend, Kansas 67530

Nearest lease or unit boundary line 330 feet  
County Lane  
Lease Name Broughton Well # 1

Well Drilled For: Well Class: Type Equipment:  
X Oil Storage X Infield X Mud Rotary  
Gas Inj Pool Ext Air Rotary  
OWWO Expl Wildcat Cable

Ground surface elevation feet MSL  
Domestic well within 330 feet: yes X no  
Municipal well within one mile: yes X no  
Depth to bottom of fresh water 80  
Depth to bottom of usable water 1250  
Surface pipe by Alternate: 1 2 X  
Surface pipe planned to be set 300  
Conductor pipe required  
Projected Total Depth 4550 feet  
Formation

IF OWWO: old well info as follows:

Operator  
Well Name  
Comp Date Old Total Depth

I certify that well will comply with K.S.A. 55-101, et seq., plus eventually plugging hole to KCC specification

Date May 6, 1987 Signature of Operator or Agent Richard L. Cornett Title VP

For KCC Use:


Conductor Pipe Required feet; Minimum Surface Pipe Required 225 feet per Alt. 40

This Authorization Expires 11-14-87 Approved By 5-14-87

Must be filed with the K.C.C. five (5) days prior to commencing well  
This card void if drilling not started within six (6) months of date received by K.C.C.

**Important procedures to follow:**

**A Regular Section of Land  
1 Mile = 5,280 Ft.**

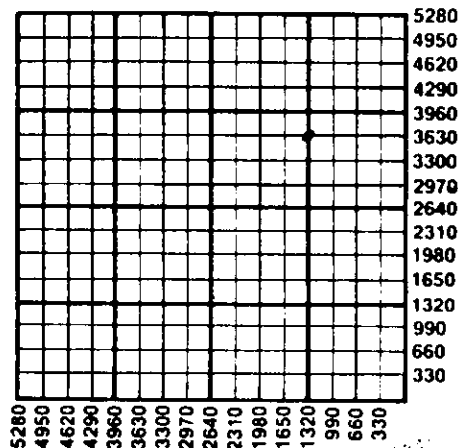

1. Notify District office before setting surface casing.
2. Set surface casing by circulating cement to the top.
3. File completion forms ACO-I with K.C.C. within 120 days of well spud date, following instructions on ACO-I, side 1, and including copies of wireline logs.
4. Notify District office 48 hours prior to old well workover or re-entry.
5. Prior to filing Intent, prepare a proposed plugging plan in case well is D & A, then obtain approval of plan when calling district office prior to setting surface pipe.
6. Submit plugging report (CP-4) to K.C.C. after plugging is completed.
7. Obtain an approved injection docket number before disposing of salt water.
8. Notify K.C.C. within 10 days when injection commences or terminates.
9. If you alternate 2 completion, cement in the production pipe from below any usable water to surface within 120 days of spud date.

RECEIVED  
MAY 14 1987

CONSERVATION DIVISION  
Wichita, Kansas

State Corporation Commission of Kansas  
Conservation Division  
200 Colorado Derby Building  
Wichita, Kansas 67202-1212  
(316) 263-3238