

CARD MUST BE TYPED

State of Kansas

CARD MUST BE SIGNED

## NOTICE OF INTENTION TO DRILL

(see rules on reverse side)

Expected Spud Date. October 30, 1988  
                                     month      day      year

OPERATOR: License # 8541

Name Petex, Inc.

Address 1111 S. Glenstone, #1-104

City/State/Zip Springfield, MO 65804

Contact Person Larry Childress

Phone (417) 862-2177

CONTRACTOR: License # 5104

Name Blue Goose Drilling

City/State Great Bend, KS

Well Drilled For:      Well Class:      Type Equipment:

☒ Oil      ☐ Storage      ☐ Infield      ☒ Mud Rotary

☐ Gas      ☐ Inj      ☐ Pool Ext.      ☐ Air Rotary

☐ OWWO      ☐ Expl      ☒ Wildcat      ☐ Cable

If OWWO: old well info as follows:

Operator .....

Well Name .....

Comp Date ..... Old Total Depth .....

I certify that well will comply with K.S.A. 55-101, et seq., plus eventually plugging hole to KCC specifications.

Date 8/15/88 Signature of Operator or Agent L Childress

For KCC Use:

Conductor Pipe Required ..... feet; Minimum Surface Pipe Required ..... 200' feet per Alt. 7 (2)

This Authorization Expires 2-18-89 Approved By LKM 8-18-88

EFFECTIVE DATE: 8-23-88

API Number 15— 101-21,483-00-00

NE NE SW      14      Twp. 19      S. Rg. 28      X East  
 2310      Sec.      West  
 2970      Ft. from South Line of Section  
                                     Ft. from East Line of Section

(Note: Locate well on Section Plat on reverse side)

Nearest lease or unit boundary line 330 feet

County Lane

Lease Name Sleeper Well # 1

Ground surface elevation 2754 feet MSL

Domestic well within 330 feet:      yes      ☒ no

Municipal well within one mile:      yes      ☒ no

Depth to bottom of fresh water. 100

Depth to bottom of usable water 1200 1250

Surface pipe by Alternate:      1      2 ☒

Surface pipe planned to be set 200

Conductor pipe required .....

Projected Total Depth 4700 feet

Formation Miss


Title President

Must be filed with the K.C.C. five (5) days prior to commencing well  
This card void if drilling not started within six (6) months of date received by K.C.C.

**Important procedures to follow:**

1. Notify District office before setting surface casing.
2. Set surface casing by circulating cement to the top.
3. File completion forms ACO-1 with K.C.C. within 120 days of well spud date, following instructions on ACO-1, side 1, and including copies of wireline logs.
4. Notify District office 48 hours prior to old well workover or re-entry.
5. Prior to filing Intent, prepare a proposed plugging plan in case well is D & A, then obtain approval of plan when calling district office prior to setting surface pipe.
6. Submit plugging report (CP-4) to K.C.C. after plugging is completed.
7. Obtain an approved injection docket number before disposing of salt water.
8. Notify K.C.C. within 10 days when injection commences or terminates.
9. If an alternate 2 completion, cement in the production pipe from below any usable water to surface within 120 days of spud date.

**A Regular Section of Land  
1 Mile = 5,280 Ft.**

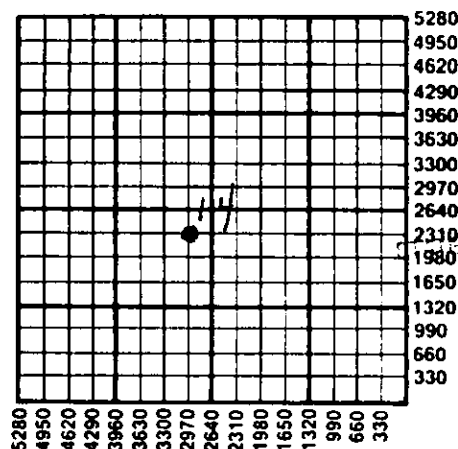

RECEIVED  
CORPORATION COMMISSION  
08-18-1988  
AUG 18 1988  
CONSERVATION DIVISION  
Wichita, Kansas

State Corporation Commission of Kansas  
Conservation Division  
200 Colorado Derby Building  
Wichita, Kansas 67202-1212  
(316) 263-3238