

CARD MUST BE SIGNED

NOTICE OF INTENTION TO DRILL

(see rules on reverse side)

Starting Date 11 21 86
month day year

API Number 15- 101-21,347 - 00-00

OPERATOR: License # 9746
 Name Wilkar Oil Company
 Address 10707 Norwalk Blvd.
 City/State/Zip Santa Fe Springs, California 80670
 Contact Person Charles Martin
 Phone 213-944-5311

SW SE Sec. 8 Twp. 19S Rg. 28W West
490 Ft. from South Line of Section
1080 Ft. from East Line of Section

(Note: Locate well on Section Plat on reverse side)

Nearest lease or unit boundary line 490 feet
County..... Lane

CONTRACTOR: License # 5302
Name Red Tiger Drilling Co.
City/State Wichita, Kansas 67202

Lease Name... Hineman Well #... 1-8

Ground surface elevation 2759 GR feet MSL

Well Drilled For:	Well Class:	Type Equipment:
☒ Oil	☐ Infield	☒ Mud Rotary
☐ Gas	☒ Pool Ext.	☐ Air Rotary
☐ OWWO	☐ Wildcat	☐ Cable
☐ SWD		
☐ Inj		
☐ Expl		

Domestic well within 330 feet: yes Xno

Municipal well within one mile: yes Xno

Depth to bottom of fresh water.....100.....

Depth to bottom of usable water 1200

Surface pipe by Alternate: 1 — 2 — X

If OWWO: old well info as follows:

Surface pipe planned to be set 250.....

Conductor pipe required N/A.....

Projected Total Depth 4700 feet

Formation... Miss.....

I certify that well will comply with K.S.A. 55-101, et seq., plus eventually plugging hole to KCO specifications.

Date 11-19-86..... Signature of Operator or Agent [Signature] Title Owner.....

For KCC Use:

BY RED TIGER DRIVING COMPANY

Conductor Pipe Required feet; Minimum Surface Pipe Required ²⁵⁰feet per Alt. 4 (2)

This Authorization Expires 5-19-87 Approved By 11-19-86


er Alt. 4 (2)

Must be filed with the K.C.C. five (5) days prior to commencing well
This card void if drilling not started within six (6) months of date received by K.C.C.

Important procedures to follow:

1. Notify District office before setting surface casing.
2. Set surface casing by circulating cement to the top.
3. File completion forms ACO-1 with K.C.C. within 90 days of well completion, following instructions on ACO-1, side 1, and including copies of wireline logs.
4. Notify District office 48 hours prior to old well workover or re-entry.
5. Prior to filing Intent, prepare a proposed plugging plan in case well is D & A, then obtain approval of plan when calling district office prior to setting surface pipe.
6. Submit plugging report (CP-4) to K.C.C. after plugging is completed.
7. Obtain an approved injection docket number before disposing of salt water.
8. Notify K.C.C. within 10 days when injection commences or terminates.
9. If an alternate 2 completion, cement in the production pipe from below any usable water to surface within 120 days of spud date.

**A Regular Section of Land
1 Mile = 5,280 Ft.**

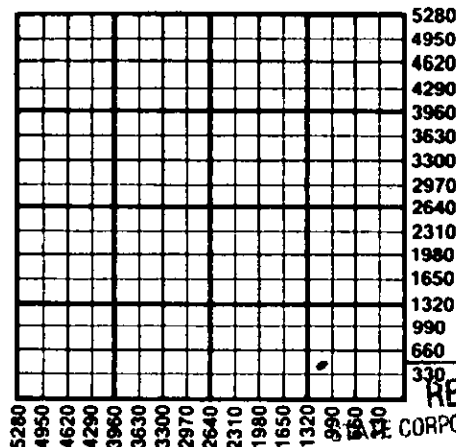

RECEIVED
CORPORATION COMMISSION
NOV 19 1986
11-19-1986
CONSERVATION DIVISION
Wichita, Kansas

State Corporation Commission of Kansas
Conservation Division
200 Colorado Derby Building
Wichita, Kansas 67202
(316) 263-3238