

NOTICE OF INTENTION TO DRILL

(see rules on reverse side)

Starting Date 11 25 87 month day year

API Number 15-135-23,190-00-00

OPERATOR: License # 5363 Name BERECCO INC. Address 970 Fourth Financial Center City/State/Zip Wichita, KS, 67202 Contact Person Eyan Mayhew Phone (316) 265-3311

C S/2 S/2 SW Sec. 11 Twp. 16 S, Rg. 21 East West 330' Ft. from South Line of Section 3960' Ft. from East Line of Section

(Note: Locate well on Section Plat on reverse side)

CONTRACTOR: License # 5147 Name BERECCO INC. City/State Wichita, KS, 67202

Nearest lease or unit boundary line 330 feet County Ness

Lease Name Ehler Well # A-1

Well Drilled For: Well Class: Type Equipment: Oil SWD Infield Mud Rotary Gas Inj Pool Ext Air Rotary OWWO Expl Wildcat Cable

Ground surface elevation unknown feet MSL

Domestic well within 330 feet: yes no

Municipal well within one mile: yes no

Surface pipe by Alternate: 1 2

If OWWO: old well info as follows: Operator Well Name Comp Date Old Total Depth

Depth to bottom of fresh water 100'

Depth to bottom of usable water 1200' 750'

Surface pipe planned to be set 280'

Projected Total Depth 4600 feet

Formation Mississippi

I certify that well will comply with K.S.A. 55-101, et seq., plus eventually plugging hole to KCC specifications.

cementing will be done immediately upon setting production casing.

Date Signature of Operator or Agent Title

For KCC Use:

Conductor Pipe Required feet; Minimum Surface Pipe Required 200 feet per Alt. X 2


This Authorization Expires 5-16-88 Effective 11-21-87 Approved By RCH 11-16-87

Must be filed with the K.C.C. five (5) days prior to commencing well
This card void if drilling not started within six (6) months of date received by K.C.C.

Important procedures to follow:

1. Notify District office before setting surface casing.
2. Set surface casing by circulating cement to the top.
3. File completion forms ACO-1 with K.C.C. within 90 days of well completion, following instructions on ACO-1, side 1, and including copies of wireline logs.
4. Notify District office 48 hours prior to old well workover or re-entry.
5. Prior to filing Intent, prepare a proposed plugging plan in case well is D & A, then obtain approval of plan when calling district office prior to setting surface pipe.
6. Submit plugging report (CP-4) to K.C.C. after plugging is completed.
7. Obtain approved injection docket number before disposing of salt water.
8. Notify K.C.C. within 10 days when injection commences or terminates.
9. If an alternate 2 completion, cement in the production pipe from below any usable water to surface within 120 days of spud date.

A Regular Section of Land
1 Mile = 5,280 Ft.

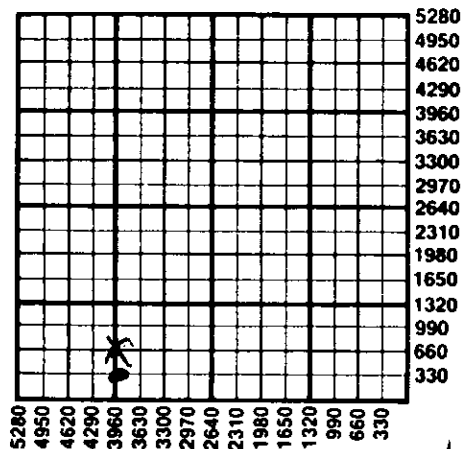

RECEIVED
STATE CORPORATION COMMISSION
NOV 16 1987
CONSERVATION DIVISION
Wichita, Kansas

11-16-1987

State Corporation Commission of Kansas
Conservation Division
200 Colorado Derby Building
Wichita, Kansas 67202
(316) 263-3238