

CARD MUST BE TYPED

State of Kansas  
NOTICE OF INTENTION TO DRILL

CARD MUST BE SIGNED

(see rules on reverse side)

Starting Date: 9 - 4 - 85  
month day year 11:50

API Number IS- 135-22,916-00-00

OPERATOR: License # 6331  
Name Taurexco, Inc. & Rains & Williamson  
Address 125 N. Market, Suite 1210  
City/State/Zip Wichita, KS 67202  
Contact Person Thomas Hyde  
Phone 316/262-8339

300' NE of SW SW Sec 11 Twp 16 S, Rge 21  East  West  
Oil Co., Inc. (local name)

approx. 872 Ft North from Southeast Corner of Section  
approx. 4408 Ft West from Southeast Corner of Section  
(Note: Locate well on Section Plat on reverse side)

CONTRACTOR: License # 5146  
Name Rains & Williamson Oil Co., Inc.  
City/State Wichita, KS

Nearest lease or unit boundary line 760 feet.

County Ness

Lease Name Eller Well # 1

Domestic well within 330 feet:  yes  no

Municipal well within one mile:  yes  no

Well Drilled For: Well Class: Type Equipment:  
 Oil  Swd  Infield  Mud Rotary  
 Gas  Inj  Pool Ext.  Air Rotary  
 OWWO  Expl  Wildcat  Cable

Depth to Bottom of fresh water 50 feet

Lowest usable water formation Dakota

Depth to Bottom of usable water 650 feet

Surface pipe by Alternate: 1  2  XX

Surface pipe to be set 300 feet

Conductor pipe if any required

Ground surface elevation feet MSL

This Authorization Expires 3-3-86

Approved By 9-3-85 [Signature]

If OWWO: old well info as follows:

Operator

Well Name

Comp Date Old Total Depth

Projected Total Depth 4200 feet

Projected Formation at TD Cherokee

Expected Producing Formations Fort. Scott Sand

I certify that we will comply with K.S.A. 55-101, et seq., plus eventually plugging hole to K.C.C. specifications. Production will be immediately  
suspended to protect the water.

Date 9/3/85 Signature of Operator or Agent

[Signature: Thomas T. Hyde]

Title President

Per [Signature]

Must be filed with the K.C.C. five (5) days prior to commencing well  
This card void if drilling not started within six (6) months of date received by K.C.C.

09-03-1985


RECEIVED  
STATE CORPORATION COMMISSION

Important procedures to follow:

A Regular Section of Land  
1 Mile = 5,280 Ft.

SEP 3 1985  
CONSERVATION DIVISION  
Wichita, Kansas

1. Notify District office before setting surface casing.
2. Set surface casing by circulating cement to the top.
3. File completion forms ACO-1 with K.C.C. within 90 days of well completion, following instructions on ACO-1, side 1, and including copies of wireline logs.
4. Notify District office 48 hours prior to old well workover or re-entry.
5. Prior to plugging, prepare a plugging plan, then obtain agreement from the appropriate district office for an approved plugging plan.
6. Submit plugging report (CP-4) to K.C.C. after plugging is completed.
7. Obtain an approved injection docket number before disposing of salt water.
8. Notify K.C.C. within 10 days when injection commences or terminates.
9. If an alternate 2 completion, cement in the production pipe from below any usable water to surface within 120 days of spud date.

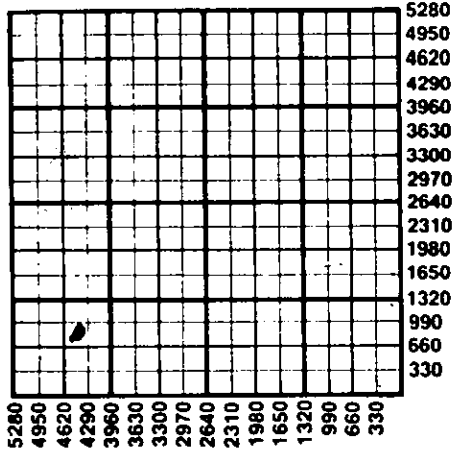

State Corporation Commission of Kansas  
Conservation Division  
200 Colorado Derby Building  
Wichita, Kansas 67202  
(316) 263-3238