

STATE OF KANSAS
STATE CORPORATION COMMISSION


Give All Information Completely
Make Required Affidavit
Mail or Deliver Report to:
Conservation Division
State Corporation Commission
211 No. Broadway
Wichita, Kansas

WELL PLUGGING RECORD

Ness County. Sec. 11 Twp. 17S Rge. (E) 21 (W)

Location as "NE/CNW%SW%" or footage from lines C NE SE
Lease Owner National Cooperative Refinery Association
Lease Name Pfaff Well No. 1
Office Address P. O. Box #6, Great Bend, Kansas 67530
Character of Well (completed as Oil, Gas or Dry Hole) Dry Hole
Date well completed September 12, 1968
Application for plugging filed September 11, 1968
Application for plugging approved September 11, 1968
Plugging commenced September 11, 1968
Plugging completed September 12, 1968
Reason for abandonment of well or producing formation Dry Hole

NORTH

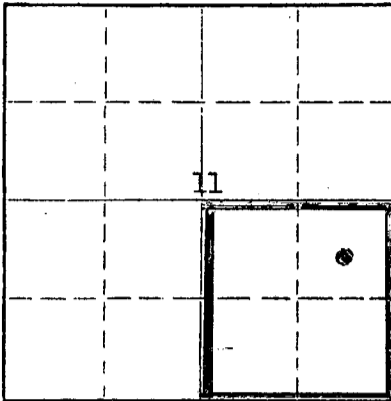

Locate well correctly on above Section Plat

If a producing well is abandoned, date of last production - - - 19
Was permission obtained from the Conservation Division or its agents before plugging was commenced? Yes

Name of Conservation Agent who supervised plugging of this well I. O. Massey
Producing formation _____ Depth to top _____ Bottom _____ Total Depth of Well 4174 Feet
Show depth and thickness of all water, oil and gas formations.

OIL, GAS OR WATER RECORDS

CASING RECORD

FORMATION	CONTENT	FROM	TO	SIZE	PUT IN	PULLED OUT
				8 5/8"	416'	None


Describe in detail the manner in which the well was plugged, indicating where the mud fluid was placed and the method or methods used in introducing it into the hole. If cement or other plugs were used, state the character of same and depth placed, from _____ feet to _____ feet for each plug set.
Spotted plug, pumped 40 sacks regular cement from 4044' to 4164'. Mudded hole to 403', set plug, pumped 25 sacks regular cement. Mudded hole to 40', set plug, pumped 8 sacks cement on up to base of cellar. Cemented rat hole with 2 sacks.

RECEIVED
STATE CORPORATION COMMISSION
SEP 19 1968
CONSERVATION DIVISION
Wichita, Kansas

09-19-1968

(If additional description is necessary, use BACK of this sheet)
Name of Plugging Contractor Globe Cementing Company
Address Great Bend, Kansas 67530

STATE OF Kansas, COUNTY OF Barton, ss.
W. F. Griffith (employee of owner) or (owner or operator) of the above-described

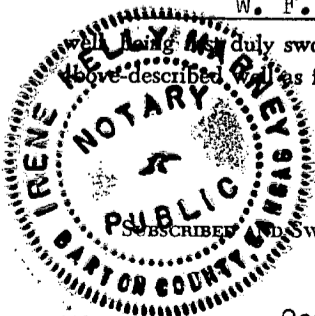

I, _____, being duly sworn on oath, says: That I have knowledge of the facts, statements, and matters herein contained and the log of the above-described well as filed and that the same are true and correct. So help me God.

(Signature) W. F. Griffith
P. O. Box #6, Great Bend, Kansas 67530
(Address)

SWORN TO before me this 16th day of September, 1968

Irene Kelly Marney
Notary Public.

My commission expires October 23, 1970

15-135-20180-00-00

ROTARY DRILLING LOG

Operator: National Cooperative Refinery Association
#1 Pfaff
C NE SE/4 11-17S-21W
Ness County, Kansas

Contractor: Omega Drilling, Inc.

Commenced: September 3, 1968
Completed: September 12, 1968

Casing Record: 8 5/8" surface casing cemented at 417' with 275 sacks.

FORMATIONS

415	Surface clay and sand
859	Red bed and shale
1136	Sand
1250	Shale
1445	Shells and shale
1504	Anhydrite
1815	Shale
2430	Shale and lime
2450	Lime
2610	Lime and shale
2725	Lime
3030	Lime and shale
3240	Lime
3575	Lime and shale
4094	Lime
4115	Lime, chert and sand
4174	Lime and chert
4174	T. D.

RECEIVED
STATE CORPORATION COMMISSION
SEP 19 1968
CONSERVATION DIVISION
Wichita, Kansas
09-19-1968

We certify that the above log is true and correct to the best of our knowledge and belief.

OMEGA DRILLING, INC.

By F. S. Woodside, Jr.
F. S. Woodside, Jr., President

Subscribed and sworn to before me, a Notary Public, in and for the State of Kansas, County of Sedgwick, this 16th day of September, 1968.

Mary L. Lawrence
Mary L. Lawrence, Notary Public

My commission expires February 28, 1971.

