

15-135-19070-00-00

STATE OF KANSAS
STATE CORPORATION COMMISSION

WELL PLUGGING RECORD

Give All Information Completely
Make Required Affidavit
Mail or Deliver Report to:
Conservation Division
State Corporation Commission
800 Bitting Building
Wichita, Kansas

Ness County. Sec. 7 Twp. 17S Rge. 21W (E) (W)

Location as "NE/CNW/SW" or footage from lines C NE NW

Lease Owner Pickrell Drilling Co.

Lease Name Yawger Well No. 1

Office Address Wichita, Kansas

Character of Well (completed as Oil, Gas or Dry Hole) Dry Hole.

Date well completed 2-10-64 19

Application for plugging filed 2-10-64 19

Application for plugging approved 2-10-64 19


Plugging commenced 2-10-64 19

Plugging completed 2-10-64 19

Reason for abandonment of well or producing formation Non productive.

If a producing well is abandoned, date of last production None 19

Was permission obtained from the Conservation Division or its agents before plugging was commenced? Yes

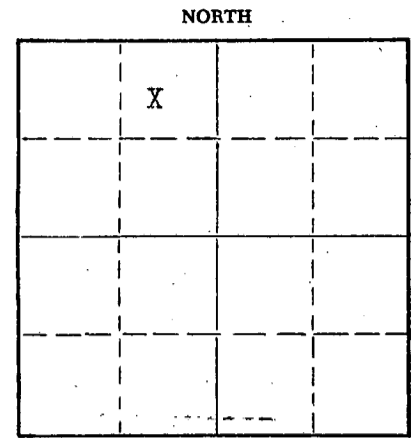

Locate well correctly on above Section Plat

Name of Conservation Agent who supervised plugging of this well Mr. Petty Hays, Kansas

Producing formation Depth to top Bottom Total Depth of Well 4290' Feet

Show depth and thickness of all water, oil and gas formations.

OIL, GAS OR WATER RECORDS

CASING RECORD

FORMATION	CONTENT	FROM	TO	SIZE	PUT IN	PULLED OUT

Describe in detail the manner in which the well was plugged, indicating where the mud fluid was placed and the method or methods used in introducing it into the hole. If cement or other plugs were used, state the character of same and depth placed, from feet to feet for each plug set.

Plugged through drill pipe with Globe Cementing Pump truck, with a plug set at 550' with 20 sacks cement a plug set at 240' with 20 sacks cement and a plug set at 40' with 16 sacks cement.

RECEIVED
STATE CORPORATION COMMISSION

FEB 25 1964
02-25-1964
CONSERVATION DIVISION
Wichita, Kansas

(If additional description is necessary, use BACK of this sheet)
Name of Plugging Contractor Mull Drilling Co Inc. tools.
Address 1625 Plaza Bldg. Wichita, Kansas

STATE OF KANSAS, COUNTY OF SEDGWICK, ss.
Joseph O. Butts (employee of owner) or (owner or operator) of the above-described well, being first duly sworn on oath, says: That I have knowledge of the facts, statements, and matters herein contained and the log of the above-described well as filed and that the same are true and correct. So help me God.

(Signature) Joseph O. Butts, Mull Drilling Co. Inc.
Wichita, Kansas (Address)

Subscribed and sworn to before me this 20th day of February 1964
October 16, 1965
Bettie H. Salter Notary Public.



15-135-19070-00-00

ROTARY DRILLER'S LOG

COMPANY: Pickrell Drilling Co. ROTARY DRILLING COMMENCED: 2/1/64
 Wichita, Kansas

CONTRACTOR: Mull Drilling Co., Inc. ROTARY DRILLING COMPLETED: 2/11/64
 Wichita, Kansas

CASING RECORD: Set 258½' - 8 5/3" Surf. Csg. w/180 sx. LOCATION: #1 Yawger
 C NE NW 7-17S-21W;
 Ness County, Kansas

(Figures indicate bottom of formation; measurements from top of Rotary Bushing.)

292'	Blue shale
1226'	Shale
1545'	Sandy shale
1585'	Anhydrite
2305'	Shale w/sand
2935'	Shale w/Lime
3740'	Sandy Lime w/Shale
4200'	Lime w/Shale
4227'	Sand w/Lime
4285'	Lime
4290'	Miss. Dolomite & chert - Total Depth.

RECEIVED
STATE CORPORATION COMMISSION

FEB 25 1964
02-25-1964
CONSERVATION DIVISION
Wichita, Kansas

I hereby certify that this is a true and correct copy of the above log to the best of my knowledge.

MULL DRILLING COMPANY, INC.

Joseph B. Brungardt, Jr.
Joseph B. Brungardt, Jr.

STATE OF KANSAS)

COUNTY OF SEDGWICK)

) Subscribed and sworn before me this 24th day of February, 1964.

Lola L. Foster

Lola L. Foster, Notary Public

Commission expires April 17, 1966.

