


WELL PLUGGING RECORD

Give All Information Completely
Make Required Affidavit
Mail or Deliver Report to
Conservation Division
State Corporation Comm.
245 North Water
Wichita, KS 67202

Ness County, Sec. 4 Twp. 17S Rge. 21W E/M
Location as "NE/CNW/SW" or footage from lines
C NW SE

Lease Owner Patton Oil Company
Lease Name Thompson Well No. #1
Office Address 5660 S. Syracuse Cr. -#200, Englewood, Co. 80110
Character of Well (Completed as Oil, Gas or Dry Hole)
Dry Hole

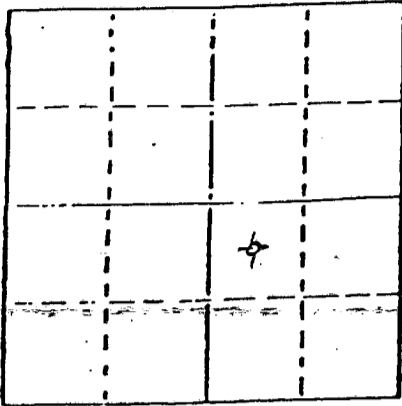

Locate well correctly on above Section Plot

Date Well completed March 11, 1983
Application for plugging filed March 11, 1983
Application for plugging approved March 11, 1983
Plugging commenced March 11, 1983
Plugging completed March 11, 1983
Reason for abandonment of well or producing formation
Dry Hole

If a producing well is abandoned, date of last production
N/A 19

Was permission obtained from the Conservation Division or its agents before plugging was commenced? Yes

Name of Conservation Agent who supervised plugging of this well Steve Durrant
Producing formation Depth to top Bottom Total Depth of Well 4300
Show depth and thickness of all water, oil and gas formations.

OIL, GAS OR WATER RECORDS

CASING RECORD

FORMATION	CONTENT	FROM	TO	SIZE	PUT IN.	PULLED OUT
Sand				8 5/8"	357'	none

Describe in detail the manner in which the well was plugged, indicating where the mud fluid was placed and the method or methods used in introducing it into the hold. If cement or other plugs were used, state the character of same and depth placed, from feet to feet for each plug set.

4280' 35 SX
1560' 50 SX
780' 50 SX
390' 40 SX
40' 10 SX
RH 15 SX

50 - 50 POZ 4% gel

(If additional description is necessary, use BACK of this sheet)

Name of Plugging Contractor Allied Cementing Co., Inc.

STATE OF Colorado COUNTY OF Arapahoe, ss.
Harold H. Patton, Jr. (employee of owner) or (owner or operator)
of the above-described well, being first duly sworn on oath, says: That I have knowledge of the facts, statements, and matters herein contained and the log of the above-described well is filed and that the same are true and correct. So help me God.

(Signature) Harold H. Patton, Jr.

(Address)

SUBSCRIBED AND SWORN TO before me this 24 day of March, 1983



My Commission expires Oct. 14, 1984

commission expires

Elaine Mundorf
PATTON OIL CO.
5660 S. Syracuse Circle
Englewood, Colorado 80111

RECEIVED STATE CORPORATION COMMISSION PUBLIC.

MAR 28 1983
03-28-1983
CONSERVATION DIVISION
Wichita, Kansas