


Give All Information Completely
Make Required Affidavit
Mail or Deliver Report to:
Conservation Division
State Corporation Commission
P. O. Box 17027
Wichita, Kansas 67217
NORTH

WELL PLUGGING RECORD

Ness County, Sec. 19 Twp. 17S Rge. (E) 21W (W)
Location as "NE/CNW/SW" or footage from lines C SW SE.
Lease Owner D N B DRILLING, INC.
Lease Name Stieben Well No. 1
Office Address 701 First Nat'l Bldg., Wichita, Kansas
Character of Well (completed as Oil, Gas or Dry Hole) Dry Hole
Date well completed 9-15 19 73
Application for plugging filed 9-15 19 73
Application for plugging approved 9-15 19 73
Plugging commenced 9-15 19 73
Plugging completed 9-15 19 73
Reason for abandonment of well or producing formation No commercial quantities of oil or gas encountered.
If a producing well is abandoned, date of last production 19
Was permission obtained from the Conservation Division or its agents before plugging was commenced? Yes

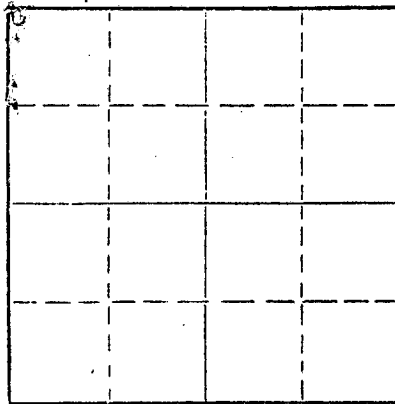

Locate well correctly on above Section Plat

Name of Conservation Agent who supervised plugging of this well Leo Massey
Producing formation _____ Depth to top _____ Bottom _____ Total Depth of Well 4330 Feet
Show depth and thickness of all water, oil and gas formations.

OIL, GAS OR WATER RECORDS

CASING RECORD

FORMATION	CONTENT	FROM	TO	SIZE	PUT IN	PULLED OUT
Surface Hole	Fluid	Surface	296	8-5/8"	288	None

Describe in detail the manner in which the well was plugged, indicating where the mud fluid was placed and the method or methods used in introducing it into the hole. If cement or other plugs were used, state the character of same and depth placed, from _____ feet to _____ feet for each plug set.

Fluid to 500', plug, 50 sx cement;
Fluid to 240', plug, 25 sx cement;
Fluid to 40', 1/2 sx hulls, plug, 10 sx cement.

RECEIVED
STATE CORPORATION COMMISSION

SEP 21 1973

CONSERVATION DIVISION
Wichita, Kansas

09-21-1973

(If additional description is necessary, use BACK of this sheet)
Name of Plugging Contractor D N B DRILLING, INC.
Address 701 First Nat'l Bk Bldg., Wichita, Kansas 67202

STATE OF KANSAS, COUNTY OF _____, ss.
JAMES L. DONELSON (employee of owner) or (owner or operator) of the above-described well, being first duly sworn on oath, says: That I have knowledge of the facts, statements, and matters herein contained and the log of the above-described well as filed and that the same are true and correct. So help me God.

(Signature) *James L. Donelson*
701 FNB Bldg., Wichita, Kansas
(Address)

SUBSCRIBED AND SWORN to before me this 20th day of Sept. 19 73
Ella Priess

My commission expires August 25, 1976 Ella Priess Notary Public.

Ella Priess
STATE NOTARY PUBLIC
Sedgwick County, Kansas
My Com. Expires Aug. 25, 1976

15-135-20791-00-00

DRILLERS' LOG

RECEIVED
STATE CORPORATION COMMISSION

SEP 21 1973
09-21-1973
CONSULTING DIVISION
Wichita, Kansas

D N B DRILLING, INC.
No. 1 Stieben
C SW SE, Sec. 19-178-21W
Ness County, Kansas

Elevation: 2225 K.B.

Commenced: 9-8-73
Completed: 9-15-73

Surface: 288.56' of 8-5/8"
cemented w/200 sx cement, 28 cc.
9-9-73

FORMATION

DEPTH

Surface Hole	0 - 296
Shale & Sand	296 - 955
Sand	955 - 1180
Shale	1180 - 1526
Anhydrite	1526 - 1561
Shale	1561 - 2160
Lime & Shale	2160 - 3845
Lime	3845 - 4260
Lime & Chert	4260 - 4320
Lime	4320 - 4330 T.D.

I do hereby certify that the foregoing statements are true and correct to the best of my knowledge and belief.

D N B DRILLING, INC.

James L. Donelson
JAMES L. DONELSON

STATE OF KANSAS: ss:

Subscribed and sworn to before me, the undersigned, a Notary Public in and for said state, this 20th day of September, 1973.

My Commission Expires:
August 25, 1976

Ella Priess
Ella Priess, Notary Public

Ella Priess
STATE NOTARY PUBLIC
Sedgwick County, Kansas
My Com. Expires Aug. 25, 1976