


STATE OF KANSAS  
CORPORATION COMMISSION

WELL PLUGGING RECORD

Give All Information Completely  
Make Required Affidavit  
Mail or Deliver Report to  
Conservation Division  
State Corporation Comm.  
245 North Water  
Wichita, KS 67202

Ness County. Sec. 14 Twp. 17S Rge. 21W E/W  
Location as "NE/CNW $\frac{1}{4}$ /SW $\frac{1}{4}$ " or footage from lines NE SW NW

Lease Owner D N B DRILLING, INC.  
Lease Name Conner 'A' Well No. 1  
Office Address 701 First Nat'l Bldg., Wichita, Ks.  
Character of Well (Completed as Oil, Gas or Dry Hole) Dry Hole

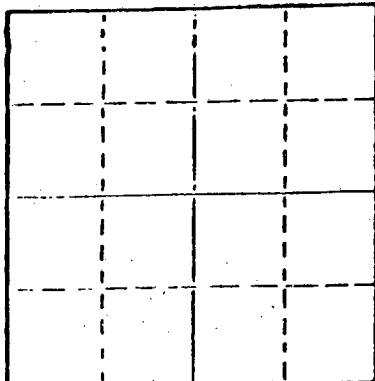

Locate well correctly on above  
Section Plat

Date Well completed 11-12 1976  
Application for plugging filed 11-12 1976  
Application for plugging approved 11-12 1976  
Plugging commenced 11-12 1976  
Plugging completed 11-12 1976  
Reason for abandonment of well or producing formation  
No commercial quantities of oil or gas encountered.  
If a producing well is abandoned, date of last production  
19

Was permission obtained from the Conservation Division or  
its agents before plugging was commenced? Yes

Name of Conservation Agent who supervised plugging of this well Leo Massey  
Producing formation \_\_\_\_\_ Depth to top \_\_\_\_\_ Bottom \_\_\_\_\_ Total Depth of Well 4200  
Show depth and thickness of all water, oil and gas formations.

OIL, GAS OR WATER RECORDS

CASING RECORD

FORMATION	CONTENT	FROM	TO	SIZE	PUT IN	PULLED OUT
Surface Hole	Shale	Surf	414	8-5/8"	406	None

Describe in detail the manner in which the well was plugged, indicating where the mud fluid was placed and the method or methods used in introducing it into the hold. If cement or other plugs were used, state the character of same and depth placed, from \_\_\_\_\_ feet to \_\_\_\_\_ feet for each plug set.

Fluid to 400', plug, 40 sx cement;  
Fluid to 40', plug, 1/2 sx hulls, 10 sx cement;

RECEIVED  
STATE CORPORATION COMMISSION

NOV 22 1976

11-22-1976

CONSERVATION DIVISION  
Wichita, Kansas

(If additional description is necessary, use back of this sheet)

Name of Plugging Contractor D N B DRILLING, INC.  
701 First National Building  
Wichita, Kansas 67202

STATE OF KANSAS COUNTY OF \_\_\_\_\_, ss.  
JAMES L. DONELSON (employee of owner) or (owner or operator)

of the above-described well, being first duly sworn on oath, says: That I have knowledge of the facts, statements, and matters herein contained and the log of the above-described well as filed and that the same are true and correct. So help me God.

(Signature) James L. Donelson  
701 First Nat'l Bldg., Wichita, Kansas 67202  
(Address)

SUBSCRIBED AND SWORN TO before me this 18th day of Nov., 19 76

Ella Priess

Notary Public.

My commission expires 8-25-80

Ella Priess



15-135-21264-00-00

DRILLERS' LOG

D N B DRILLING, INC.  
No. 1 Conner 'A'  
NE SW NW, Sec. 14-17S-21W  
Ness County, Kansas

Elev: 2196 K.B.

Commenced: 11-4-76  
Completed: 11-12-76

Surface Casing: 406' of  
8-5/8" cemented w/250 sx  
common cement, 2% Gel, 3% cc.  
11-4-76

FORMATION

DEPTH

Surface Hole	0 - 414
Sand & Shale	414 - 650
Shale & Sand	650 - 1357
Shale & Red Bed	1357 - 1466
Anhydrite	1466 - 1500
Shale	1500 - 2252
Shale & Lime	2252 - 2475
Lime & Shale	2475 - 3380
Shale & Lime	3380 - 3615
Lime & Shale	3615 - 3755
Lime	3755 - 3905
Shale & Lime	3905 - 4012
Lime	4012 - 4106
Lime & Shale	4106 - 4115
Lime	4115 - 4200 RTD

RECEIVED  
STATE OF KANSAS  
NOV 22 1976  
11-22-1976  
COMMISSIONER OF GEOLOGY  
TOPEKA, KANSAS

I do hereby certify that the foregoing statements are true and correct to the best of my knowledge and belief.

D N B DRILLING, INC.

*James L. Donelson*  
JAMES L. DONELSON

STATE OF KANSAS: ss:

Subscribed and sworn to before me this 18th day of November, 1976.

*Ella Priess*  
Ella Priess, Notary Public

