

15-135-20015-00-00

STATE OF KANSAS
STATE CORPORATION COMMISSION


Form CP-4

Give All Information Completely
Make Required Affidavit
Mail or Deliver Report to:
Conservation Division
State Corporation Commission
212 No. Market
Wichita, Kansas

WELL PLUGGING RECORD

Ness County, Sec. 14 Twp. 17S Rge. (E) 21W(W)

Location as "NE/CNWxSWx" or footage from lines C E/2 SW NE
Lease Owner Pickrell Drilling Company
Lease Name Elmore "D" Well No. 3
Office Address 705 Fourth National Bank Bldg., Wichita, Kansas
Character of Well (completed as Oil, Gas or Dry Hole) Dry Hole
Date well completed March 1, 19 67
Application for plugging filed March 1, 19 67
Application for plugging approved March 1, 19 67
Plugging commenced March 1, 19 67
Plugging completed March 1, 19 67
Reason for abandonment of well or producing formation Dry Hole

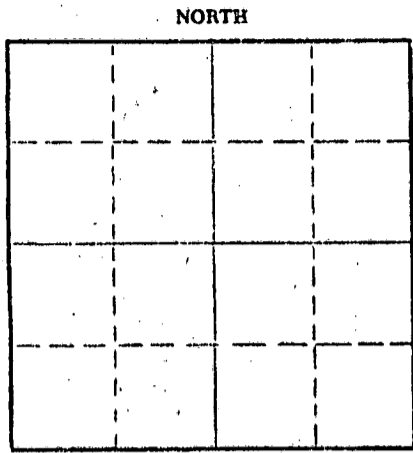

Locate well correctly on above Section Plat

If a producing well is abandoned, date of last production 19
Was permission obtained from the Conservation Division or its agents before plugging was commenced? Yes

Name of Conservation Agent who supervised plugging of this well Leo F. Massey
Producing formation Depth to top Bottom Total Depth of Well 4160 Feet
Show depth and thickness of all water, oil and gas formations.

OIL, GAS OR WATER RECORDS

CASING RECORD

FORMATION	CONTENT	FROM	TO	SIZE	PUT IN	PULLED OUT
				8 5/8"	400'	None

RECEIVED
MAR 10 1967
CONSERVATION DIVISION
WICHITA, KANSAS

Describe in detail the manner in which the well was plugged, indicating where the mud fluid was placed and the method or methods used in introducing it into the hole. If cement or other plugs were used, state the character of same and depth placed, from feet to feet for each plug set.

Heavy mud to 600'. Set plug. Cemented with
25 sacks cement. Heavy mud to 390'. Set plug.
Cemented with 20 sacks cement. Heavy mud to 40'.
Set plug. Cemented with 10 sacks cement to bottom
of cellar. Plugged rat hole with 2 sacks cement.

(If additional description is necessary, use BACK of this sheet)

Name of Plugging Contractor Pickrell Drilling Company
Address 705 Fourth National Bank Bldg., Wichita, Kansas

STATE OF KANSAS, COUNTY OF SEDGWICK, ss.
C. W. SEBITS (owner or operator) of the above-described

well, first duly sworn on oath, says: That I have knowledge of the facts, statements and matters herein contained and the log of the well as filed and that the same are true and correct. So help me God.

(Signature) C. W. Sebits
705 Fourth National Bank Bldg., Wichita, Ks.
(Address)

Sworn to before me this 8th day of March, 19 67



L. M. Whiting
Notary Public.

My commission expires May 10, 1970

ROTARY DRILLING LOG

COMPANY: Pickrell Drilling Company
705 Fourth National Bank Bldg.
Wichita, Kansas

Rotary Drilling Commenced 2/20/67

Rotary Drilling Completed 3/1/67

LOCATION: Elmore "D" No. 3
C E/2 SW NE Section 14-17S-21W
Ness County, Kansas

CONTRACTOR: **PICKRELL DRILLING COMPANY**
Wichita, Kansas

CASING RECORD: (16 jts.) 8 5/8" surface casing set at 400' and cemented with 185 sacks cement. Circulated. Complete @ 1:15 AM, February 21, 1967. No oil string was run. D. & A.

LOG

(Figures indicate bottom of formation — measurements from top of rotary bushing.)

40	Clay & Bentonite	C.F.S.
700	Shale & Shells	4098'
875	Red Beds & Shale	4103'
1137	Sand	4125'
1455	Red Bed, Shale & Shells	4160'
1489	Anhydrite	
1590	Shale & Shells	
2160	Shale & Salt	
4091	Lime & Shale	
4125	Sand & Shale	Slope Tests
4160	Mississippian, RTD	3000
		3500
		4000

	S.L.M.
Board	3810.32
Strap	3808.39
Diff.	1.93

RECEIVED
WICHITA CORPORATION COMMISSION
MAR 10 1967
03-10-1967
CONSERVATION DIVISION
Wichita, Kansas

The undersigned, C. W. SEBITS, Attorney-in-Fact for PICKRELL DRILLING COMPANY, hereby certifies in behalf of said Company, that the above is a true and correct log of the formation encountered in drilling the above well as reflected by the Daily Drilling Reports.

PICKRELL DRILLING COMPANY

By C. W. SEBITS, Attorney-in-Fact

STATE OF KANSAS }
COUNTY OF SEDGWICK } ss.:

On this 8th day of March, 19 67, before me the undersigned, a Notary Public, in and for the County and State aforesaid, personally appeared C. W. SEBITS, to me known to be the identical person who subscribed the name of PICKRELL DRILLING COMPANY to the foregoing instrument as its Attorney-in-Fact and acknowledged to me that he executed the same as his free and voluntary act and deed, and as the free and voluntary act and deed of such company, for the uses and purposes therein set forth.

Given under my hand and seal of office the day and year last above written.

My commission expires: May 10, 1970

L. M. Whiting
Notary Public