


STATE OF KANSAS
STATE CORPORATION COMMISSION

Form CP-4

Give All Information Completely
Make Required Affidavit
Mail or Deliver Report to:
Conservation Division
State Corporation Commission
P. O. Box 17027
Wichita, Kansas 67217
NORTH

WELL PLUGGING RECORD

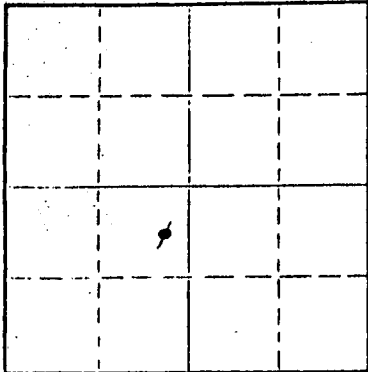

Locate well correctly on above
Section Plat

Ellis County. Sec. 31 Twp. 11 Rge. (E) 17 (W)
Location as "NE/CNW&SW" or footage from lines CE/2 NE SW
Lease Owner Lario Oil & Gas Company
Lease Name Marshall "A" Well No. 8
Office Address 301 S. Market, Wichita, Kansas 67202
Character of Well (completed as Oil, Gas or Dry Hole) Oil
Date well completed July 27, 19 74
Application for plugging filed July 24, 19 74
Application for plugging approved July 25, 19 74
Plugging commenced August 21, 19 74
Plugging completed August 26, 19 74
Reason for abandonment of well or producing formation Depleted

If a producing well is abandoned, date of last production February 28, 19 70
Was permission obtained from the Conservation Division or its agents before plugging was commenced? Yes

Name of Conservation Agent who supervised plugging of this well Leo Massey
Producing formation Arbuckle Depth to top Bottom Total Depth of Well 3668
Show depth and thickness of all water, oil and gas formations.

OIL, GAS OR WATER RECORDS

CASING RECORD

FORMATION	CONTENT	FROM	TO	SIZE	PUT IN	PULLED OUT
				8 5/8	1150	None
				5 1/2	3644	2495

Describe in detail the manner in which the well was plugged, indicating where the mud fluid was placed and the method or methods used in introducing it into the hole. If cement or other plugs were used, state the character of same and depth placed, from feet to feet for each plug set.

Checked bottom, ran sand to 3620' and dumped 4 sacks cement.
Shot pipe at 2742', 2645', 2545', pulled 83 joints. Bailed hole to 435', set 10' rock bridge and dumped 6 yards ready mix.

RECEIVED
STATE CORPORATION COMMISSION
AUG 29 1974
CONSERVATION DIVISION
Wichita, Kansas

(If additional description is necessary, use BACK of this sheet)
Name of Plugging Contractor Knight Casing Pulling Co., Inc.
Address Chase, Kansas

STATE OF Kansas COUNTY OF Sedgwick ss.
M. E. Kraft (employee of owner) or (owner or operator) of the above-described well, being first duly sworn on oath, says: That I have knowledge of the facts, statements, and matters herein contained and the log of the above-described well as filed and that the same are true and correct. So help me God.

(Signature) *M. E. Kraft*
301 S. Market, Wichita, Kansas 67202
(Address)

SUBSCRIBED AND SWORN TO before me this 28th day of August, 19 74

My commission expires July 21, 1978

Notary Public.


WELL LOG BUREAU - KANSAS GEOLOGICAL SOCIETY
412 Union National Bk Bldg., Wichita, Kansas

LARIO OIL & GAS CO.
Marshall No. 8.

SEC.31 T.11 R.17W
CE $\frac{1}{2}$ NE SW

Total Depth. 3668'
Comm. 7-9-40 Comp. 7-27-40
Shot or Treated. 4000 Gals. Acid
Contractor. Springrose Drlg. Co.
Issued. 9-14-40

County. Ellis

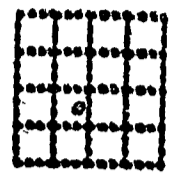

CASING:
8 $\frac{1}{4}$ " 1150'
5 $\frac{1}{2}$ " 3644 $\frac{1}{2}$ '

3645
2132
1513

Elevation.

Production. Pot. 2564 B.

Figures Indicate Bottom of Formations.

sand & clay	300
shale & shells	620
shale	625
sand	745
shale	920
shale & red bed	1340
anhydrite	1390
shale	1650
shale & red bed	1710
shale & salt	1830
shale & shells	2000
lime brkn	2110
shale	2185
shale & lime	2305
lime brkn	2445
shale & lime	2550
shale & shells	2635
shale & lime	2770
shale & lime shells	2900
lime	2920
shale & lime	2975
shale & shells	3090
shale & lime	3120
lime	3450
shale	3460
shale & lime	3480
lime	3550
shale & lime	3605
shale variegated	3620
shale Simpson	3643
Arbuckle dolomite	3668
Total Depth.	

RECEIVED
STATE CORPORATION COMMISSION
JUL 25 1974
CONSERVATION DIVISION
Wichita, Kansas