

STATE OF KANSAS
STATE CORPORATION COMMISSION

Give All Information Completely
Make Required Affidavit
Mail or Deliver Report to:
Conservation Division
State Corporation Commission
800 Bittling Building
Wichita, Kansas

WELL PLUGGING RECORD

Ellis County, Sec. 31 Twp. 11S Rge. 17 (E) 17 (W)

Location as "NE/CNW/SW" or footage from lines Center SE/4

Lease Owner Walters Drilling Co., et al

Lease Name Hadley "C" Well No. 1

Office Address 510 Orpheum Building, Wichita 2, Kansas

Character of Well (completed as Oil, Gas or Dry Hole) Dry Hole

Date well completed October 23, 1954

Application for plugging filed (verbal) October 23, 1954

Application for plugging approved (verbal) November 5, 1954


Plugging commenced November 5, 1954

Plugging completed November 5, 1954

Reason for abandonment of well or producing formation Dry Hole

If a producing well is abandoned, date of last production 10

Was permission obtained from the Conservation Division or its agents before plugging was commenced? Yes

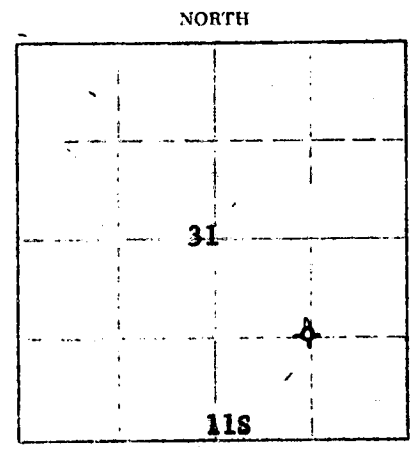

Locate well correctly on above Section Plat

Name of Conservation Agent who supervised plugging of this well Eldon Petty

Producing formation _____ Depth to top _____ Bottom _____ Total Depth of Well 3667 Feet

Show depth and thickness of all water, oil and gas formations.

OIL, GAS OR WATER RECORDS

CASING RECORD

FORMATION	CONTENT	FROM	TO	SIZE	PUT IN	PULLED OUT
None	None	0	176'	8 5/8"	176'	None
Arbuckle	None			5 1/2"	3658.28'	2990.77'

Describe in detail the manner in which the well was plugged, indicating where the mud fluid was placed and the method or methods used in introducing it into the hole. If cement or other plugs were used, state the character of same and depth placed, from _____ feet to _____ feet for each plug set.

Plugged back with sand from 3662' to 3640'

Cemented with 4 sacks from 3640' to 3612'

Pulled 2,990.77' of 5 1/2" casing

Squeezed hole with 25 sacks Gel mud followed by 60 sacks cement

Pumped by Globe Oilwell Cementing Company

(If additional description is necessary, use BACK of this sheet)

Name of Plugging Contractor R & D Casing Pulling Company (Permit #236)

Address Ellinwood, Kansas

STATE OF KANSAS COUNTY OF SEDGWICK, ss.

Russell I. Baker (employee of owner) or ~~(owner)~~ of the above-described well, being first duly sworn on oath, says: That I have knowledge of the facts, statements, and matters herein contained and the log of the above-described well as filed and that the same are true and correct. So help me God.

(Signature) Russell I. Baker

510 Orpheum Building, Wichita 2, Kansas

(Address)

SUBSCRIBED AND SWORN TO before me this 23rd day of November, 19 54

Pauline Hedrick
Notary Public.

My commission expires March 10, 1956

PLUGGING

FILE SEC 31 T 11 R 12 W

BOOK PAGE 26 LINE 15

