


STATE OF KANSAS
STATE CORPORATION COMMISSION

WELL PLUGGING RECORD

Give All Information Completely
Make Required Affidavit
Mail or Deliver Report to:
Conservation Division
State Corporation Commission
211 No. Broadway
Wichita, Kansas

Ellis County. Sec. 31 Twp. 11 Rge. 17 (E) W (W)
Location as "NE/CNW%SW%" or footage from lines SW/4 SW/4 SE/4
Lease Owner Republic Natural Gas Company
Lease Name Hadley Well No. 1
Office Address Box 126, Ellinwood, Kansas
Character of Well (completed as Oil, Gas or Dry Hole) Oil
Date well completed September 27 19 37
Application for plugging filed September 30 19 58
Application for plugging approved October 1 19 58
Plugging commenced November 12 19 58
Plugging completed November 21 19 58
Reason for abandonment of well or producing formation Depleted

NORTH

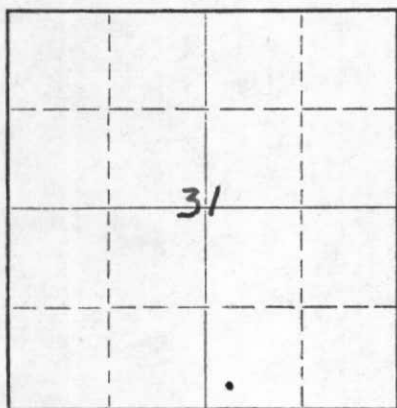

Locate well correctly on above Section Plat

If a producing well is abandoned, date of last production June 11 19 58
Was permission obtained from the Conservation Division or its agents before plugging was commenced? Yes

Name of Conservation Agent who supervised plugging of this well Eldon Petty
Producing formation Arbuckle Depth to top 3611 Bottom _____ Total Depth of Well 3637 Feet
Show depth and thickness of all water, oil and gas formations.

OIL, GAS OR WATER RECORDS

CASING RECORD

FORMATION	CONTENT	FROM	TO	SIZE	PUT IN	PULLED OUT
				10-3/4"	1053'	None
				7"	3614'	2165'
				5-1/2"	1329'*	None
				*Liner from 2291' to 3620'		

Describe in detail the manner in which the well was plugged, indicating where the mud fluid was placed and the method or methods used in introducing it into the hole. If cement or other plugs were used, state the character of same and depth placed, from _____ feet to _____ feet for each plug set.

Well had been plugged back to 3444'. Hole filled with sand from 3444' to 3400' (casing perforated at 3422'). Four sacks of cement placed in bottom of hole with dump bailer. Globe Oil Well Cementing Company's pump trucks pumped down fifty-five sacks of mud through 10-3/4" in surface pipe and 25 sacks of cement displaced by 20 sacks of mud after pipe had been pulled followed by 15 sacks of cement pumped down on top capping hole to bottom of cellar.

RECEIVED
STATE CORPORATION COMMISSION
DEC 6 - 1958
CONSERVATION DIVISION
Wichita, Kansas

(If additional description is necessary, use BACK of this sheet)
Name of Plugging Contractor Barnes and Sons Pipe Pulling Company
Address Russell, Kansas

STATE OF Kansas, COUNTY OF Barton, ss.
P. B. Horst (employee of owner) or (owner or operator) of the above-described well, being first duly sworn on oath, says: That I have knowledge of the facts, statements, and matters herein contained and the log of the above-described well as filed and that the same are true and correct. So help me God.

(Signature) P. B. Horst
Box 126, Ellinwood, Kansas
(Address)

SUBSCRIBED AND SWORN TO before me this 5th day of December, 1958

My commission expires 8-20-59 Yvonne M. Stevenson Notary Public.

PLUGGING
FILE SEC 31 T 11 R 17W
BOOK PAGE 133 LINE 25

HADLEY #1

Location: SW SW SE Section 31-11S-17W, Ellis County, Kansas

Owner: Republic Natural Gas Company

Contractor: J. E. Trigg Drilling Company, Oklahoma City, Oklahoma

Commenced: 6-7-37


Completed: 7-20-37

Total Depth: 3637'

Elevation: 2093'

<u>Depth</u>		<u>Formation</u>
From	To	
0	90	Lime
90	385	Shale
385	476	Shale & Shells
476	525	Sand
525	540	Shale
540	560	Sand
560	640	Shale
640	655	Sandy Lime
655	722	Sand (Hard)
722	840	Shale & Shells
840	922	Sand
922	988	Sand
988	1038	Red Bed
1038	1046	Lime
1046	1055	Lime
1055	1322	Red Bed
1322	1375	Lime
1375	1500	Red Bed
1500	1514	Shale
1514	1644	Shale & Red Bed
1644	1675	Shale
1675	1860	Shale
1860	1915	Shale & Lime Shells
1915	2030	Lime
2030	2063	Lime & Shale
2063	2080	Shale & Shells
2080	2128	Lime
2128	2150	Shale
2150	2260	Lime
2260	2308	Lime & Shale
2308	2320	Shale
2320	2340	Lime
2340	2348	Shale
2348	2367	Shale & Shells
2367	2425	Lime
2425	2445	Shale & Shells

Hole reamed to 13-3/4"
10-3/4" 32.75# csg set at 1053'

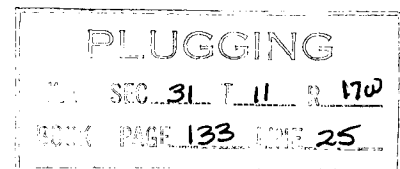

Page 2
 Hadley #1, SW SW SE
 Section 31-11S-17W, Ellis County, Kansas

From	To	Formation
2445	2460	Sand
2460	2480	Shale & Shells
2480	2512	Shale
2512	2520	Lime
2520	2530	Shale
2530	2560	Lime
2560	2570	Red Bed
2570	2580	Lime
2580	2585	Shale
2585	2612	Lime & Shale
2612	2627	Shale
2627	2658	Lime
2658	2822	Shale & Lime Shells
2822	2860	Shale
2860	2875	Lime
2875	2899	Shale
2899	2905	Shale
2905	2930	Lime
2930	2948	Brk. Lime & Shale
2948	2990	Brk. Lime & Shale
2990	3037	Shale
3037	3050	Lime
3050	3085	Brk. Lime
3085	3297	Lime
3297	3298	Shale
3298	3352	Lime
3352	3395	Lime
3395	3400	Lime & Brk. Shale
3400	3466	Lime
3466	3470	Cored Lime w/4' Rec., show of oil
3470	3480	Lime
3480	3510	Lime
3510	3519	Cored Lime
3519	3584	Lime
3584	3598	Brk. Shale & Lime
3598	3606	Shale
3606	3615	Lime
3615	3621	Lime
3621	3624	Siliceous
3624	3627	Dolomite (light brown)
3627	3629	Dolomite
3629	3631	Dolomite & Chert
3631	3633	Dolomite & Chert
3633	3634	Dolomite & Chert
3634	3637'	Dolomite & Chert - TOTAL DEPTH

Set 3612' of 7" 24# Casing

PLUGGING	
FILE SEC.	31 T 11 R 17W
BOOK PAGE	133 LINE 25