

1 040365

11-28

API NUMBER 15-135-23,410-00-00

NW SE SW, SEC. 36, T 16 S, R 25 W/E

990 feet from S section line

3630 feet from E section line

Lease Name Berry-Froelich Well # 2

County Ness 146.74

Well Total Depth 4515 feet

Conductor Pipe: Size _____ feet

Surface Casing: Size 8 5/8 feet 316

To: STATE CORPORATION COMMISSION
CONSERVATION DIVISION - PLUGGING SECTION
200 COLORADO DERBY BUILDING
WICHITA, KANSAS 67202

TECHNICIAN'S PLUGGING REPORT

Operator License # 7261

Operator: Pate-Dombaugh, Inc.

Name &

Address 150 North Main Street, Suite 804

Wichita, KS 67202

Abandoned Oil Well _____ Gas Well _____ Input Well _____ SWD Well _____ D&A X

Other well as hereinafter indicated _____

Plugging Contractor Mallard JV, Inc. License Number 4958

Address P.O. Box 2009, McPherson, KS 67460

Company to plug at: Hour: 9 a.m. Day: 28 Month: 11 Year: 19 89

Plugging proposal received from Arnie Hess

(company name) Mallard JV, Inc. (phone) 316-241-4640

were: to fill hole with heavy mud and spot cement through drill pipe Anhydrite 1828-59'

1st plug at 1860' with 50 sx cement, 2nd plug at 1018' with 80 sx cement,

3rd plug at 340' with 40 sx cement, 4th plug at 40' with 10 sx cement,

5th plug to circulate rathole with 15 sx cement,

6th plug to circulate mousehole with 10 sx cement.

Plugging Proposal Received by Steve Pfeifer
(TECHNICIAN)

Plugging Operations attended by Agent?: All _____ Part _____ None X

Operations Completed: Hour: 10 a.m. Day: 28 Month: 11 Year: 19 89

ACTUAL PLUGGING REPORT 1st plug at 1860' with 50 sx cement,

2nd plug at 1018' with 80 sx cement,

3rd plug at 340' with 40 sx cement,

4th plug at 40' with 10 sx cement,

5th plug to circulate rathole with 15 sx cement,

6th plug to circulate mousehole with 10 sx cement.

Remarks: Used 60/40 Pozmix 6% gel by Allied.

(if additional description is necessary, use BACK of this form.)

INVOICED

(321) did not observe this plugging.

DATE 12-7-89

INV. NO. 26690

11-28

Signed Stephen J. Pfeifer
(TECHNICIAN)

RECEIVED
STATE CORPORATION COMMISSION
11-30-89
NOV 30 1989
CONSERVATION DIVISION
Wichita, Kansas

EFFECTIVE DATE: 11-21-89

State of Kansas 135-23,410-00-00

NOTICE OF INTENTION TO DRILL

Must be approved by the K.C.C. five (5) days prior to commencing well

Expected Spud Date ... Nov. 22 1989
month day year

.NW. .SE .SW. Sec .36. Twp 16. S, Rg 25 X West

OPERATOR: License # 7261
Name: Pate-Dombaugh, Inc.
Address: 150 N. Main St. Suite 804
City/State/Zip: Wichita, KS 67202
Contact Person: Don R. Pate
Phone: 316-262-5993

990 feet from South line of Section
3630 feet from East line of Section
(Note: Locate well on Section Plat Below)

CONTRACTOR: License #: 4958
Name: Mallard JV, Inc.

County: Ness
Lease Name: Berry-Froelich Well #: 2
Field Name: Unnamed

Well Drilled For: Well Class: Type Equipment:
.X Oil ... Inj .X Infield .X Mud Rotary
... Gas ... Storage ... Pool Ext. ... Air Rotary
... OAWO ... Disposal ... Wildcat ... Cable
... Seismic; ... # of Holes

Is this a Prorated Field? ... yes .X no
Target Formation(s): Mississippian
Nearest lease or unit boundary: 990
Ground Surface Elevation: 2485 Est. feet MSL
Domestic well within 330 feet: ... yes .X no
Municipal well within one mile: ... yes .X no
Depth to bottom of fresh water: 100-150 Ft.
Depth to bottom of usable water: 900 Ft.
Surface Pipe by Alternate: 1 .X 2
Length of Surface Pipe Planned to be set: 300 Ft.
Length of Conductor pipe required: None
Projected Total Depth: 4450 Ft.
Formation at Total Depth: Mississippian
Water Source for Drilling Operations: well farm pond .X other

If OAWO: old well information as follows:
Operator:
Well Name:
Comp. Date: Old Total Depth

Directional, Deviated or Horizontal wellbore? ... yes .X no
If yes, total depth location:

DWR Permit #:
Will Cores Be Taken?: ... yes .X no
If yes, proposed zone:


Exp. 5/16/90

200' Alt. II Req.

AFFIDAVIT

PUSHER Annie Heber
TD 4451 FORMATION
SURFACE PIPE 8 5/8 @ 316
ANHYDRITE 1828 ELEVATION
STARTING TIME & DATE 9:00 A.M.
COMPLETION TIME & DATE 10: A.M.
1st PLUG @ 1860 FT. W/ 50 SX
2nd PLUG @ 1018 FT. W/ 80 SX
3rd PLUG @ 340 FT. W/ 40 SX
4th PLUG @ 40 FT. W/ 10 SX
RAT HOLE CIRCULATED W/ 15 SX
MOUSE HOLE CIRCULATED W/ 10 SX
WATER WELL PLUGGED W/ none SX
CEMENT COMPANY Allied
TECHNICIAN S.P.
TYPE OF CEMENT 60/40/16

SPUD
NOV 20 1989
NOV 30 1989
Wichita, Kansas
Case No. 200-185/3

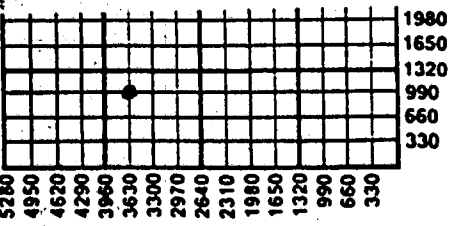

Wichita, Kansas

(In months or effective date.)
Spud date: _____ Agent: _____

REMEMBER TO:

- File Drill Pit Application (form CDP-1) with Intent to Drill;
- File Completion Form ACO-1 within 120 days of spud date;
- File acreage attribution plat according to field proration orders;
- Notify appropriate district office 48 hours prior to workover or re-entry;
- Submit plugging report (CP-4) after plugging is completed;
- Obtain written approval before disposing or injecting salt water.