

FOR KCC USE:

FORM C-1 7/91

EFFECTIVE DATE: 1-1-97

FORM MUST BE TYPED

DISTRICT 4

State of Kansas
NOTICE OF INTENTION TO DRILL

FORM MUST BE SIGNED
ALL BLANKS MUST BE FILLED

SEAT Y-1 V-40

Must be approved by the K.C.C. five (5) days prior to commencing well

Expected Spud Date January 6 1996
month day year

Spot East
SE NE NE Sec 20 Twp 19 S Rg 28 X West

OPERATOR: License # 6039
Name: L. D. Drilling, Inc.
Address: R.R. 1, Box 183 B
City/State/Zip: Great Bend, Kansas 67530
Contact Person: L. D. Davis
Phone: (316) 793-3051

990 feet from South/North line of Section
330 feet from East West line of Section
IS SECTION X REGULAR IRREGULAR

(NOTE: Locate well on the Section Plat on Reverse Side)
County: LANE
Lease Name: Tahuren Well #: 1
Field Name: Unnamed

CONTRACTOR: License # 6039
Name: L. D. Drilling, Inc.

Is this a Prorated/Spaced Field? yes X no
Target Formation(s): Mississippian

Well Drilled For: Well Class: Type Equipment:
X Oil ... Enh Rec ... Infield X Mud Rotary
... Gas ... Storage ... Pool Est. ... Air Rotary
... OWWO ... Disposal X Wildcat ... Cable
... Seismic ... # of Holes ... Other
... Other

Nearest lease or unit boundary: 330
Ground Surface Elevation: 2782 feet MSL
Water well within one-quarter mile: yes X no
Public water supply well within one mile: yes X no

If OWWO, old well information as follows:
Operator:
Well Name:
Comp. Date: Old Total Depth

Depth to bottom of fresh water: 120
Depth to bottom of usable water: 1250, 1300
Surface Pipe by Alternate: 1 X 2
Length of Surface Pipe Planned to be set: 250'

Directional, Deviated or Horizontal wellbore? yes X no
If yes, true vertical depth:
Bottom Hole Location:

Length of Conductor pipe required: none
Projected Total Depth: 4700'

Formation at Total Depth: Mississippian
Water Source for Drilling Operations:
... well ... farm pond X ... other

DWH Permit #: ...
Will Cores be Taken? yes X no
If yes, proposed zone:

AFFIDAVIT

The undersigned hereby affirms that the drilling, completion and eventual plugging of this well will comply with K.S.A. 55-101, et. seq.
It is agreed that the following minimum requirements will be met:

1. Notify the appropriate district office prior to spudding of well;
2. A copy of the approved notice of intent to drill shall be posted on each drilling rig;
3. The minimum amount of surface pipe as specified below shall be set by circulating cement to the top; in all cases surface pipe shall be set through all unconsolidated materials plus a minimum of 20 feet into the underlying formation;
4. If the well is dry hole, an agreement between the operator and the district office on plug length and placement is necessary prior to plugging;
5. The appropriate district office will be notified before well is either plugged or production casing is cemented in;
6. IF AN ALTERNATE IS COMPLETION, PRODUCTION PIPE SHALL BE CEMENTED FROM BELOW ANY USABLE WATER TO SURFACE WITHIN 120 DAYS OF SPUD DATE. IN ALL CASES, NOTIFY DISTRICT OFFICE PRIOR TO ANY CEMENTING.

I hereby certify that the statements made herein are true and to the best of my knowledge and belief.

Date: 12-26-96 Signature of Operator or Agent: [Signature] Title: Sec/Treas

FOR KCC USE:
API # 15-101-21734-0000
Conductor pipe required NONE feet
Minimum surface pipe required 200 feet per Alt. X(2)
Approved by: DPW 12-27-96

This authorization expires: 6-27-97
(This authorization void if drilling not started within 6 months of effective date.)
Spud date: Agent:

REMEMBER TO:

- File Drill Pit Application (form CDP-1) with Intent to Drill;
- File Completion Form ACD-1 within 120 days of spud date;
- File acreage attribution plat according to field proration orders;
- Notify appropriate district office 48 hours prior to workover or re-entry;
- Submit plugging report (CP-4) after plugging is completed;
- Obtain written approval before disposing or injecting salt water.

Mail to: Conservation Division, 200 Colorado Derby Building, 202 W. First St., Wichita, Kansas 67202-1286.

12-27-96
RECEIVED
KANSAS CONSERVATION DIVISION
DEC 27 4 12 45 PM '96
20
19
28w

IN ALL CASES PLOT THE INTENDED WELL ON THE PLAT BELOW.

PLAT OF ACREAGE ATTRIBUTABLE TO A WELL IN A PRORATED OR SPACED FIELD

If the intended well is in a prorated or spaced field, please fully complete this side of the form. If the intended well is in a prorated or spaced field complete the plat below showing that the well will be properly located in relationship to other wells producing from the common source of supply. Please show all the wells within 1 mile of the boundaries of the proposed acreage attribution unit for gas wells and within 1/2 mile of the boundaries of the proposed acreage attribution unit for oil wells.

API NO. 15- _____
 OPERATOR _____
 LEASE _____
 WELL NUMBER _____
 FIELD _____

LOCATION OF WELL: COUNTY _____ Lane _____
 990 feet from south/north line of section
 330 feet from east/west line of section
 SECTION 20 TWP 19S RC 28W



NUMBER OF ACRES ATTRIBUTABLE TO WELL 10
 QTR/QTR/QTR OF ACREAGE SE - NE - NE

IS SECTION x REGULAR or IRREGULAR
 IF SECTION IS IRREGULAR, LOCATE WELL FROM NEAREST
 CORNER BOUNDARY.

Section corner used: X NE NW SE SW

PLAT

(Show location of the well and shade attributable acreage for prorated or spaced wells.)
 (Show footage to the nearest lease or unit boundary line.)

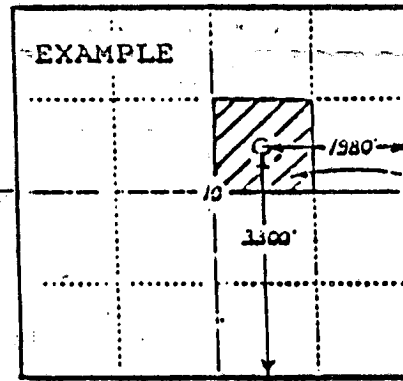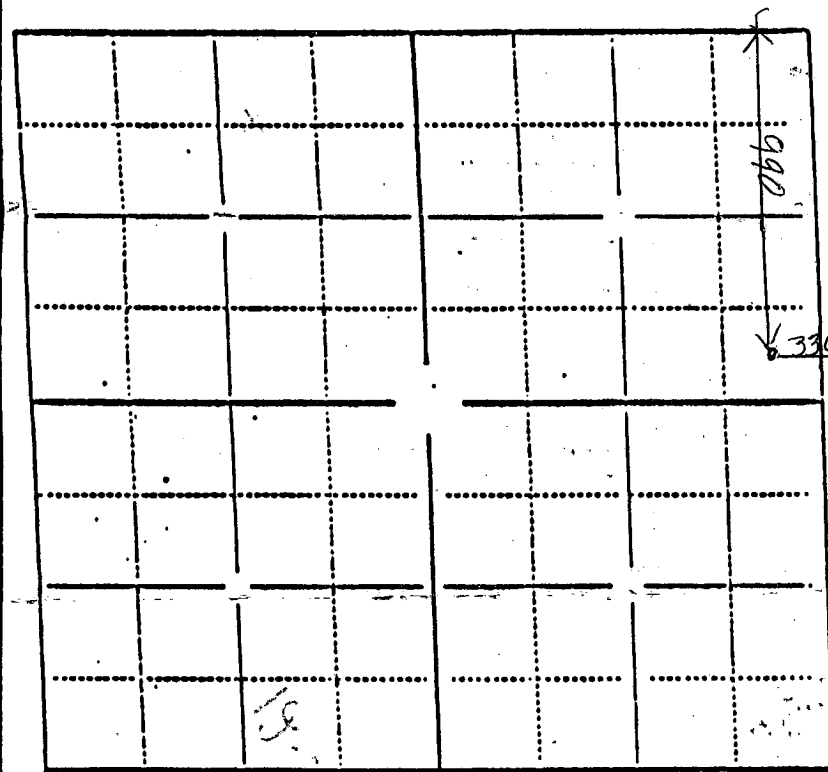

40 ACRES

In plotting the proposed location of the well, you must show:

- 1) The manner in which you are using the depicted plat by identifying section lines, i.e. 1 section, 1 section with 8 surrounding sections, 4 sections, etc.;
- 2) the distance of the proposed drilling location from the section's south/north and east/west lines; and
- 3) the distance to the nearest lease or unit boundary line.