

CARD MUST BE TYPED

State of Kansas

CARD MUST BE SIGNED

# NOTICE OF INTENTION TO DRILL

(see rules on reverse side)

Expected Spud Date. .... 7 ..... 10 ..... 88 .....  
month day year

API Number 15— 135-23,271-00-00

DA

OPERATOR: License # 5015  
Name C&R Drilling Co.  
Address 410 17th st. Suite 1140  
City/State/Zip Denver, Co. 80202  
Contact Person Les Olson  
Phone 303-623-6144

C SW SE 26 16 24 XX East  
660 West  
1990 1980 Ft. from South Line of Section  
Ft. from East Line of Section

(Note: Locate well on Section Plat on reverse side)

CONTRACTOR: License # 9087  
Name R&C Drilling Co. Inc.  
City/State Box 296, Hays, KS. 67601

Nearest lease or unit boundary line 660 feet  
County Ness  
Lease Name Glaze Well # 1

Well Drilled For: Well Class: Type Equipment:  
 Oil  Storage  Infield  Mud Rotary  
 Gas  Inj  Pool Ext.  Air Rotary  
 OWWO  Expl  Wildcat  Cable

Ground surface elevation 2508 feet MSL  
Domestic well within 330 feet:  yes  no  
Municipal well within one mile:  yes  no  
Depth to bottom of fresh water 100'  
Depth to bottom of usable water 1000'  
Surface pipe by Alternate: 1  2   
Surface pipe planned to be set 300'  
Conductor pipe required N/A  
Projected Total Depth 4600 feet  
Formation Miss.

If OWWO: old well info as follows:  
Operator .....  
Well Name .....  
Comp Date ..... Old Total Depth.....

I certify that well will comply with K.S.A. 55-101, et seq., plus eventually plugging hole to KCC specifications.

Date ..... Signature of Operator or Agent ..... Title.....

For KCC Use:  
Conductor Pipe Required ..... feet; Minimum Surface Pipe Required ..... 200 ..... feet per Alt.  2  
This Authorization Expires 1-5-89 Approved By P.H. 7-5-88


EFFECTIVE DATE: 7-10-88

Must be filed with the K.C.C. five (5) days prior to commencing well  
This card void if drilling not started within six (6) months of date received by K.C.C.

**Important procedures to follow:**

1. Notify District office before setting surface casing.
2. Set surface casing by circulating cement to the top.
3. File completion forms ACO-1 with K.C.C. within 120 days of well spud date, following instructions on ACO-1, side 1, and including copies of wireline logs.
4. Notify District office 48 hours prior to old well workover or re-entry.
5. Prior to filing Intent, prepare a proposed plugging plan in case well is D & A, then obtain approval of plan when calling district office prior to setting surface pipe.
6. Submit plugging report (CP-4) to K.C.C. after plugging is completed.
7. Obtain an approved injection docket number before disposing of salt water.
8. Notify K.C.C. within 10 days when injection commences or terminates.
9. If an alternate 2 completion, cement in the production pipe from below any usable water to surface within 120 days of spud date.

**A Regular Section of Land  
1 Mile = 5,280 Ft.**

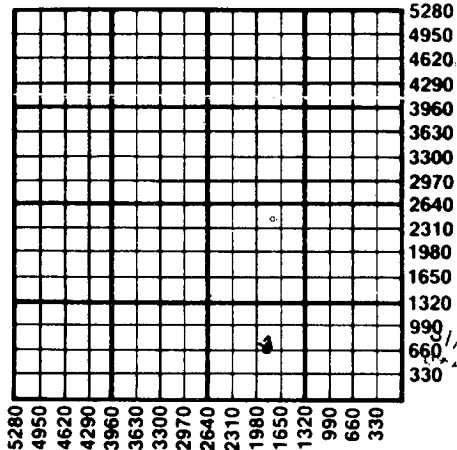

RECEIVED  
STATE CORPORATION COMMISSION  
WICHITA, KANSAS  
5 1988  
07-05-1988

State Corporation Commission of Kansas  
Conservation Division  
200 Colorado Derby Building  
Wichita, Kansas 67202-1212  
(316) 263-3238