

FOR KCC USE:

FORM C-1 7/91

EFFECTIVE DATE: 9-21-94

FORM MUST BE TYPED

DISTRICT # 1

State of Kansas
NOTICE OF INTENTION TO DRILL

FORM MUST BE SIGNED

SEA? Yes No

Must be approved by the K.C.C. five (5) days prior to commencing well

ALL BLANKS MUST BE FILLED

Expected Spud Date ... October 1, 1994 ... Spot E 7 2 NE NW Sec 12 Twp 16 S. Rg 24 East
month day year

OPERATOR: License # 5005 ✓
Name: Sunburst Exploration Company, Inc.
Address: 224 E. Douglas, Suite 520
City/State/Zip: Wichita, KS 67202
Contact Person: Ron Irion
Phone: 262-3041

660 feet from South / North line of Section
2200 feet from East / West line of Section
IS SECTION REGULAR IRREGULAR?
(NOTE: Locate well on the Section Plat on Reverse Side)
County: Ness
Lease Name: Blocksome Well #: 1
Field Name:

CONTRACTOR: License #: 5104 ✓
Name: Blue Goose Drilling, Inc.

Is this a Prorated/Spaced Field? ... yes no
Target Formation(s): Mississippian ✓
Nearest lease or unit boundary: 440'
Ground Surface Elevation: 2485' feet MSL
Water well within one-quarter mile: ... yes no
Public water supply well within one mile: ... yes no
Depth to bottom of fresh water: 900' Dakota ✓
Depth to bottom of usable water: 1025' Cheyenne ✓
Surface Pipe by Alternate: ... 1 2
Length of Surface Pipe Planned to be set: (300!) 240' ✓
Length of Conductor pipe required: NONE ✓
Projected Total Depth: 4600' ✓
Formation at Total Depth: Mississippian ✓
Water Source for Drilling Operations:
... well ... farm pond other ✓
DWR Permit #: _____
Will Cores Be Taken?: ... yes no
If yes, proposed zone: _____

Well Drilled For: Well Class: Type Equipment:
* Oil ... Enh Rec ... Infield X. Mud Rotary
Gas ... Storage ... Pool Ext. ... Air Rotary
OUWO ... Disposal X. Wildcat ... Cable
Seismic: # of Holes ... Other
Other
If OUWO: old well information as follows:
Operator:
Well Name:
Comp. Date: Old Total Depth

Directional, Deviated or Horizontal wellbore? ... yes ... no
If yes, true vertical depth:
Bottom Hole Location:

AFFIDAVIT

The undersigned hereby affirms that the drilling, completion and eventual plugging of this well will comply with K.S.A. 55-101, et. seq.

It is agreed that the following minimum requirements will be met:

- 1. Notify the appropriate district office prior to spudding of well;
- 2. A copy of the approved notice of intent to drill shall be posted on each drilling rig;
- 3. The minimum amount of surface pipe as specified below shall be set by circulating cement to the top; in all cases surface pipe shall be set through all unconsolidated materials plus a minimum of 20 feet into the underlying formation;
- 4. If the well is dry hole, an agreement between the operator and the district office on plug length and placement is necessary prior to plugging;
- 5. The appropriate district office will be notified before well is either plugged or production casing is cemented in;
- 6. IF AN ALTERNATE II COMPLETION, PRODUCTION PIPE SHALL BE CEMENTED FROM BELOW ANY USABLE WATER TO SURFACE WITHIN 120 DAYS OF SPUD DATE. IN ALL CASES, NOTIFY DISTRICT OFFICE PRIOR TO ANY CEMENTING.

I hereby certify that the statements made herein are true and to the best of my knowledge and belief.

Date: 9-13-94 Signature of Operator or Agent: [Signature] Title: President

FOR KCC USE:
API # 15- 135-23 832-00-00
Conductor pipe required NONE feet
Minimum surface pipe required 240' feet per Alt. ① X
Approved by: CB 9-16-94
This authorization expires: 3-16-95
(This authorization void if drilling not started within 6 months of effective date.)
Spud date: Agent:

REMEMBER TO:

- File Drill Pit Application (form CDP-1) with Intent to Drill;
- File Completion Form ACO-1 within 120 days of spud date;
- File acreage attribution plat according to field proration orders;
- Notify appropriate district office 48 hours prior to workover or re-entry;
- Submit plugging report (CP-4) after plugging is completed;
- Obtain written approval before disposing or injecting salt water.

Mail to: Conservation Division, 200 Colorado Derby Building, 202 W. First St., Wichita, Kansas 67202-1286.

12
16
24

IN ALL CASES PLOT THE INTENDED WELL ON THE PLAT BELOW
PLAT OF ACREAGE ATTRIBUTABLE TO A WELL IN A PRORATED OR SPACED FIELD

If the intended well is in a prorated or spaced field, please fully complete this side of the form. If the intended well is in a prorated or spaced field complete the plat below showing that the well will be properly located in relationship to other wells producing from the common source of supply. Please show all the wells within 1 mile of the boundaries of the proposed acreage attribution unit for gas wells and within 1/2 mile of the boundaries of the proposed acreage attribution unit for oil wells.

API NO. 15- _____
 OPERATOR _____
 LEASE _____
 WELL NUMBER _____
 FIELD _____



LOCATION OF WELL: COUNTY Ness
 _____ 660 feet from south/north line of section
 _____ 2200 feet from east/west line of section
 SECTION 12 TWP 16 S RG 24 W

NUMBER OF ACRES ATTRIBUTABLE TO WELL _____
 QTR/QTR/QTR OF ACREAGE _____

IS SECTION X REGULAR or _____ IRREGULAR
 IF SECTION IS IRREGULAR, LOCATE WELL FROM NEAREST
 CORNER BOUNDARY.
 Section corner used: _____ NE _____ NW X SE _____ SW

PLAT

(Show location of the well and shade attributable acreage for prorated or spaced wells.)
 (Show footage to the nearest lease or unit boundary line.)

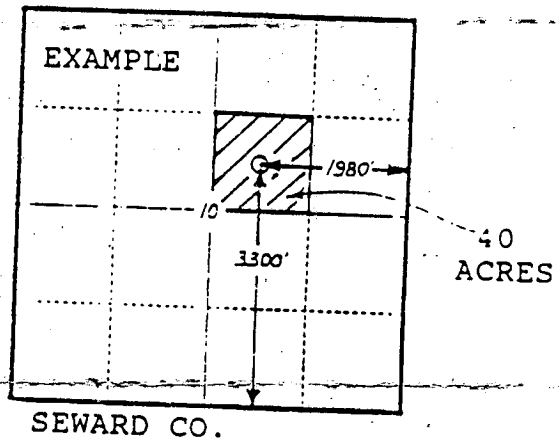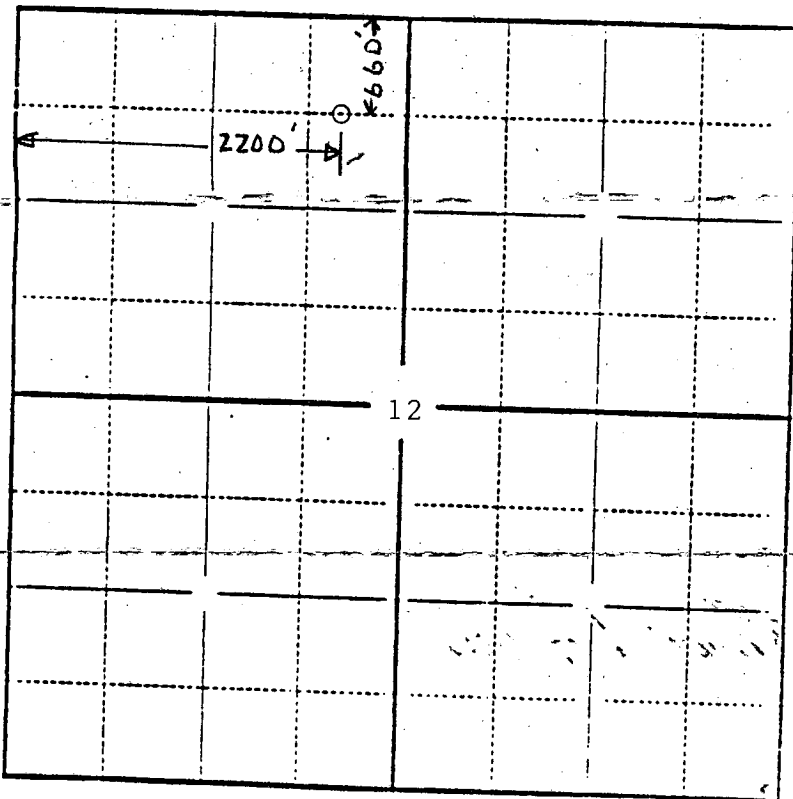

In plotting the proposed location of the well, you must show:

- 1) The manner in which you are using the depicted plat by identifying section _____, 1 section, 1 section with 8 surrounding sections, 4 sections; etc.;
- 2) the distance of the proposed drilling location from the section's _____ south/north and east/west lines; and
- 3) the distance to the nearest lease or unit boundary line.

RECEIVED
 STATE CORPORATION COMMISSION
 SEP 15 1994
 CO. REGULATION DIVISION
 WICHITA, KANSAS

09-15-1994