

CARD MUST BE TYPED

State of Kansas
NOTICE OF INTENTION TO DRILL
(see rules on reverse side)

CARD MUST BE SIGNED

Starting Date: 01-21-85
month day year

API Number 15- 101-21, 119-0000

OPERATOR: License # 5020
Name Rine Exploration Company
Address Suite #645, 300 W. Douglas
City/State/Zip Wichita, KS 67202
Contact Person M. Bradford Rine
Phone 316/262-5418

SW¹/₄ NW¹/₄ NE¹/₄ Sec 18 Twp 19 S, Rge 28 ~~XXXXXX~~
(location) West

4,290 Ft North from Southeast Corner of Section
2,310 Ft West from Southeast Corner of Section
(Note: Locate well on Section Plat on reverse side)

CONTRACTOR: License # 5147
Name Beredco, Inc.
City/State Wichita, KS 67202

Nearest lease or unit boundary line 330 feet.
County Lane
Lease Name Hineman Well# 1-18

Well Drilled For: Well Class: Type Equipment:
 Oil Swd Infield Mud Rotary
 Gas Inj Pool Ext. Air Rotary
 OWWO Expl Wildcat Cable

Domestic well within 330 feet: yes no
Municipal well within one mile: yes no

If OWWO: old well info as follows:

Operator
Well Name
Comp Date Old Total Depth
Projected Total Depth 4700 feet
Projected Formation at TD Mississippian
Expected Producing Formations Lower Pennsylvanian

Depth to Bottom of fresh water 200 feet
Lowest usable water formation Dakota
Depth to Bottom of usable water 110.0 feet
Surface pipe by Alternate: 1 2
Surface pipe to be set 320 feet
Conductor pipe if any required N/A feet
Ground surface elevation 2786 feet MSL
This Authorization Expires 7-16-85
Approved By 1-16-85

I certify that we will comply with K.S.A. 55-101, et seq., plus eventually plugging hole to K.C.C. specifications.

Date 01/15/85 Signature of Operator or Agent


M. Bradford Rine Title Partner / Geologist

MHC/KDHE 1-16-85

Must be filed with the K.C.C. five (5) days prior to commencing well
 This card void if drilling not started within six (6) months of date received by K.C.C.

Important procedures to follow :

**A Regular Section of Land
 1 Mile = 5,280 Ft.**

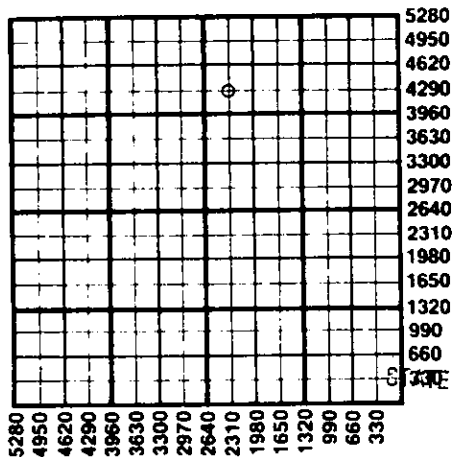

1. Notify District office before setting surface casing.
2. Set surface casing by circulating cement to the top.
3. File completion forms ACO-1 with K.C.C. within 90 days of well completion, following instructions on ACO-1, side I, and including copies of wireline logs.
4. Notify District office 48 hours prior to old well workover or re-entry.
5. Prior to plugging, prepare a plugging plan, then obtain agreement from the appropriate district office for an approved plugging plan.
6. Submit plugging report (CP-4) to K.C.C. after plugging is completed.
7. Obtain an approved injection docket number before disposing of salt water.
8. Notify K.C.C. within 10 days when injection commences or terminates.

in alternate 2 completion, cement in the production pipe from below
 water to surface within 120 days of spud date.

RECEIVED
 STATE CORPORATION COMMISSION
 JAN 16 1985
 1-16-85
 CONSERVATION DIVISION
 Wichita, Kansas

State Corporation Commission of Kansas
 Conservation Division
 200 Colorado Derby Building
 Wichita, Kansas 67202
 (316) 263-3238