

15-135-22614-00-00


STATE OF KANSAS
STATE CORPORATION COMMISSION

WELL PLUGGING RECORD

Give All Information Completely
Make Required Affidavit
Mail or Deliver Report to
Conservation Division
State Corporation Comm.
245 North Water
Wichita, KS 67202

Ness County, Sec. 19 Twp. 16S Rge. 22 ~~XX~~/W
Location as "NE/CNW $\frac{1}{2}$ SW $\frac{1}{2}$ " or footage from lines
NE NW NW

Lease Owner Blue Goose Drilling Co., Inc.
Lease Name Snodgrass "C" Well No. 1
Office Address P.O. Box 1413 Great Bend, KS 67530
Character of Well (Completed as Oil, Gas or Dry Hole)

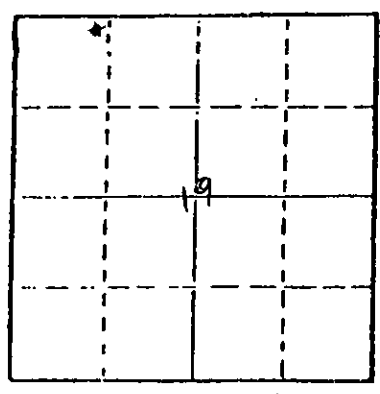

Locate well correctly on above
Section Plat

DRY HOLE
Date Well completed 7-8- 19 84
Application for plugging filed 7-7- 19 84
Application for plugging approved 7-7- 19 84
Plugging commenced 7-7- 19 84
Plugging completed 7-8- 19 84
Reason for abandonment of well or producing formation

DRY HOLE
If a producing well is abandoned, date of last production 19

Was permission obtained from the Conservation Division or
its agents before plugging was commenced? YES

Name of Conservation Agent who supervised plugging of this well Don Ubel
Producing formation Depth to top Bottom Total Depth of Well 4510'
Show depth and thickness of all water, oil and gas formations.

OIL, GAS OR WATER RECORDS

CASING RECORD

FORMATION	CONTENT	FROM	TO	SIZE	PUT IN	PULLED OUT
Surface		0	292'	8 5/8	289'	0

Describe in detail the manner in which the well was plugged, indicating where the mud fluid
was placed and the method or methods used in introducing it into the hold. If cement or other
plugs were used, state the character of same and depth placed, from feet to
feet for each plug set.

4510' T.D. 185 Sacks 60-40 Posmix 3% cc 2% Gel
1st Plug at 1800' with 50 Sacks
2nd Plug at 895' with 60 Sacks
3rd Plug at 340' with 50 Sacks
Top Plug at 40' Solid Bridge & Hulls with 10 Sacks
Rathole 15 Sacks
Plug down 1:15 A.M. 7-8-84
Sun Cementers

(If additional description is necessary, use BACK of this sheet)

Name of Plugging Contractor Blue Goose Drilling Co., Inc. # 5104

STATE OF KANSAS COUNTY OF BARTON, ss.
George E. Miller, Jr. (employee of owner) or (owner or operator)
of the above-described well, being first duly sworn on oath, says: That I have knowledge of
the facts, statements, and matters herein contained and the log of the above-described well
as filed and that the same are true and correct. So help me God.

(Signature) George E. Miller, Jr.
P.O. Box 1413 Great Bend, KS 67530
(Address)

SUBSCRIBED AND SWORN TO before me this 9th day of July, 19 84

Helen C. Standley
Notary Public.

My commission expires 12-8-87

HELEN C. STANDLEY
Barton County, Kansas
My Appt. Exp. 12-8-87

RECEIVED
STATE CORPORATION COMMISSION
07-12-1984
JUL 12 1984
CONSERVATION DIVISION
Wichita, Kansas