


STATE OF KANSAS
STATE CORPORATION COMMISSION

15-135-00070-00-00

WELL PLUGGING RECORD

Give All Information Completely
Make Required Affidavit
Mail or Deliver Report to:
Conservation Division
State Corporation Commission
211 No. Broadway
Wichita, Kansas

Location as "NE/CNW/SW" or footage from lines Ness County, Sec. 18 Twp. 16S Rge. 22W (E) (W)
Lease Owner K & E, Brown & Fortier
Lease Name Snodgrass Well No. 1
Office Address _____
Character of Well (completed as Oil, Gas or Dry Hole) _____
Date well completed 10-28-56 19_____
Application for plugging filed 10-26-56 19_____
Application for plugging approved 10-26-56 19_____
Plugging commenced 10-28-56 19_____
Plugging completed 10-28-56 19_____
Reason for abandonment of well or producing formation _____

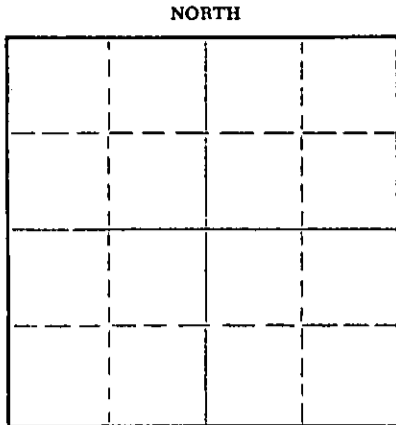

Locate well correctly on above Section Plat

If a producing well is abandoned, date of last production _____ 19_____
Was permission obtained from the Conservation Division or its agents before plugging was commenced? yes

Name of Conservation Agent who supervised plugging of this well _____
Producing formation _____ Depth to top _____ Bottom _____ Total Depth of Well 4466 Feet
Show depth and thickness of all water, oil and gas formations.

OIL, GAS OR WATER RECORDS

CASING RECORD

FORMATION	CONTENT	FROM	TO	SIZE	PUT IN	PULLED OUT
				8-5/8	226'	


Describe in detail the manner in which the well was plugged, indicating where the mud fluid was placed and the method or methods used in introducing it into the hole. If cement or other plugs were used, state the character of same and depth placed, from _____ feet to _____ feet for each plug set.

Push bridging plug to 780' cement thru 27 m joints DP with 80 sx cmt and then 80 sx thru 23 jts and heavy mud to base of surface and up to 35' of top. Plug & 10 sx cmt at 35' Plugging complete.

(If additional description is necessary, use BACK of this sheet)

Name of Plugging Contractor K & E DRILLING, INC.
Address 719 Union Center Building, Wichita, Kansas

STATE OF KANSAS, COUNTY OF SEDGWICK, ss.
Dale Silcott (employee of owner) or ~~(owner or operator)~~ of the above-described well, being first duly sworn on oath, says: That I have knowledge of the facts, statements, and matters herein contained and the log of the above-described well as filed and that the same are true and correct. So help me God.
(Signature) Dale Silcott
Dale Silcott
719 Union Center, Wichita, Kansas
(Address)

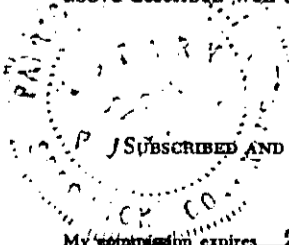

I SUBSCRIBED AND SWORN to before me this 2nd day of November, 19 56
My commission expires 2 August 11th, 1958.
Patricia M. Edwards Notary Public.

PLUGGING
FILE SEC 18 T. 16 R. 22W
BOOK PAGE 111 LINE 17

CONSERVATION DIVISION
Wichita, Kansas
11-09-1954

15-135-00070-00-00

W E L L L O G

OPERATOR: K & E, BROWN & FORTIER
719 Union Center Building
Wichita, Kansas

FARM NAME:

#1 SNODGRASS

LOCATION:

NW NW NW
Sec. 18-16S-22W
Ness County, Kansas

CONTRACTOR: K & E DRILLING, INC.
719 Union Center Building
Wichita 2, Kansas

COMMENCE:

10-15-56

COMPLETE:

10-28-56

CASING: 8-5/8" @ 226 (150 sx)

PRODUCTION:

D & A

R.T.D 4466'

FORMATION RECORD

Depths shown indicate the bottoms of the formations

Surface Clay	40
Sand	60
Lime & Shale	226
Shale & Shells	575
Sand & Sals	900
Shale & Shells	1035
Sand	1500
Shale	1785
Anhydrite	1830
Shale & Shells	2385
Shale & Lime	2555
Lime & Shale	2740
Lime	2910
Lime & Shale	3430
Lime	3485
Lime & Shale	3610
Lime	4105
Lime & Shale	4155
Lime	4290
Lime & Shale	4420
Mississippi	4466
R.T.D.	4466

CERTIFICATION

STATE OF KANSAS

COUNTY OF SEDGWICK

} SS

I hereby certify that the above information is true and correct to the best of my knowledge.

Dale Silcott
Dale Silcott

Subscribed and sworn to before me this 1st day of November, 1956.

Patricia M. Edwards
Patricia M. Edwards, Notary Public

My commission expires: 11 August 1958.

REC-11-03-1954

PLUGGING
FILE SEC 18 T 16 R 22W
BOOK PAGE 111 LI. E. 17