


15-135-00315-00-00

WELL PLUGGING RECORD

Give All Information Completely
Make Required Affidavit
Mail or Deliver Report to:
Conservation Division
State Corporation Commission
211 No. Broadway
Wichita, Kansas

Ness County, Sec. 16 Twp. 16S Rge. 22W (E) (W)
Location as "NE/CNW&SW¼" or footage from lines C NE NE
Lease Owner Mull Drilling Co., Inc.
Lease Name Wilson "B" Well No. 1
Office Address 1625 Wichita Plaza, Wichita, Kansas
Character of Well (completed as Oil, Gas or Dry Hole) D & A
Date well completed April 8 19 64
Application for plugging filed April 8 19 64
Application for plugging approved April 8 19 64
Plugging commenced April 8 19 64
Plugging completed April 8 19 64
Reason for abandonment of well or producing formation D & A

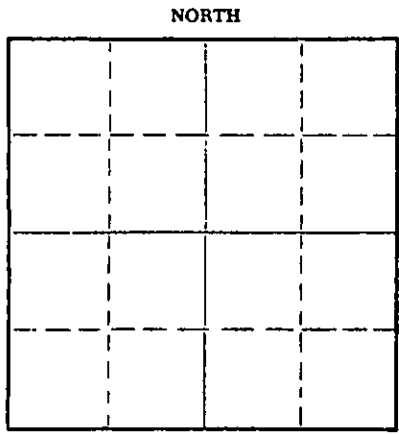

Locate well correctly on above
Section Plat

If a producing well is abandoned, date of last production 19
Was permission obtained from the Conservation Division or its agents before plugging was commenced? Yes

Name of Conservation Agent who supervised plugging of this well Eldon Petty
Producing formation _____ Depth to top _____ Bottom _____ Total Depth of Well 4419 Feet
Show depth and thickness of all water, oil and gas formations.

OIL, GAS OR WATER RECORDS

CASING RECORD

FORMATION	CONTENT	FROM	TO	SIZE	PUT IN	PULLED OUT
				8 5/8"	250'	-0-

Describe in detail the manner in which the well was plugged, indicating where the mud fluid was placed and the method or methods used in introducing it into the hole. If cement or other plugs were used, state the character of same and depth placed, from _____ feet to _____ feet for each plug set.

Filled hole w/mud to 550'
Set plug, 20 sx cement.
Filled hole w/mud to 240'
Set plug, 20 sx cement.
Filled hole to 40', set
plug, 10 sx cement.

RECEIVED
STATE CORPORATION COMMISSION

APR 14 1964
04-14-1964
CONSERVATION DIVISION
Wichita, Kansas

(If additional description is necessary, use BACK of this sheet)
Name of Plugging Contractor Red Tiger Drilling Company
Address Box 173--Russell, Kansas

STATE OF KANSAS COUNTY OF SEDGWICK, ss.
Maxine V. Head (employee of owner) of the above-described well, being first duly sworn on oath, says: That I have knowledge of the facts, statements, and matters herein contained and the log of the above-described well as filed and that the same are true and correct. So help me God.

(Signature) Maxine V. Head
1720 Wichita Plaza, Wichita, Kansas
(Address)

SUBSCRIBED AND SWORN TO before me this 10th day of April, 19 64

My commission expires 5-22-66 Jean Holler Notary Public.

15-135-00315-00-00

DRILLER LOG

Wilson "F" #1

CASING RECORD: 6 5/8" @ 150' w/175 ex cement
 COMPANY: Hull Drilling Co., Inc.
 CONTRACTOR: Red Tiger Drilling Co.
 COMMENCED: March 20, 1964
 COMPLETED: April 9, 1964
 DESCRIPTION: C NR NR
 10-102-22V
 Hess Co.,
 Kansas
 ELEVATION: 2424 DF
 2427 BB

TOTAL DEPTH: 4410'

FORMATION	FROM	TO	REMARKS
Clay & Post Rock	0	40	
Sand	40	60	
Sandy Shale	60	150	
Shale	150	250	
Shale & Shells	250	710	
Shale	710	1018	
Sand	1018	1075	
Shale Shells & Sand	1075	1075	
Shale	1075	1750	
Anhydrite	1750	1750	
Redbed Shale	1750	1975	
Shale Shells & Redbed	1975	2210	
Shale	2210	2300	
Shale & Lime	2300	3185	
Lime	3185	3300	
Lime & Shale	3300	3695	
Lime	3695	4410	
Chert	4410	4410	

RECEIVED
 STATE CORPORATION COMMISSION
 APR 14 1964
 04-14-1964
 CONSERVATION DIVISION
 Wichita, Kansas

I certify that this is a true and correct copy of the above log to the best of my knowledge.

RED TIGER DRILLING COMPANY

Maxine V. Head
 Maxine V. Head

Subscribed and sworn to before me this 10th day of April, 1964.

Jean Dallas
 Notary Public

My Commission Expires:

5-22-66