

WELL PLUGGING RECORD


OR

~~FORMATION PLUGGING RECORD~~

Strike out upper line when reporting plugging of formations.

Give All Information Completely
Make Required Affidavit
Mail or Deliver Report to:
Conservation Division
State Corporation Commission
800 Bittling Building
Wichita, Kansas

NORTH

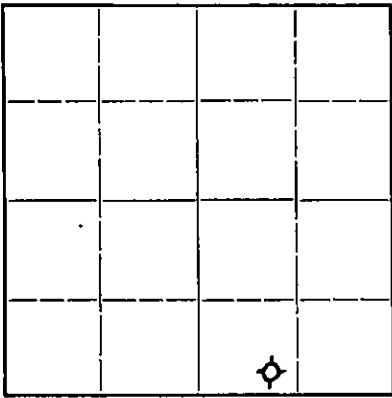

Locate well correctly on above Section Plat

Ness County. Sec. 27 Twp. 17S Rge. (E) 25 (W)
Location as "NE $\frac{1}{4}$ NW $\frac{1}{4}$ SW $\frac{1}{4}$ " or footage from lines SE SW SE
Lease Owner Magnolia Petroleum Company
Lease Name Reed A Well No. 1
Office Address Box 888, Ellinwood, Kansas
Character of Well (completed as Oil, Gas or Dry Hole) Dry Hole
Date well completed August 11, 1943
Application for plugging filed Telephone August 11, 1943
Application for plugging approved 19
Plugging commenced August 11, 1943
Plugging completed August 11, 1943
Reason for abandonment of well or producing formation Dry Hole

If a producing well is abandoned, date of last production 19
Was permission obtained from the Conservation Division or its agents before plugging was commenced? Yes

Name of Conservation Agent who supervised plugging of this well Mr. C.T. Alexander, Great Bend, Kansas.
Producing formation None Depth to top Bottom Total Depth of Well 4790 Feet
Show depth and thickness of all water, oil and gas formations.

OIL, GAS OR WATER RECORDS

CASING RECORD

Formation	Content	From	To	Size	Put In	Pulled Out
Mississippi Lime	No Oil	4406	4757	10-3/4"	378	None
Shale	No Oil	4757	4762			
Misener Sand	No Oil	4762	4774			
Viola Lime	No Oil	4774	4790			

Describe in detail the manner in which the well was plugged, indicating where the mud fluid was placed and the method or methods used in introducing it into the hole. If cement or other plugs were used, state the character of same and depth placed, from feet to feet for each plug set.

Filled heavy mud thru drill pipe from 4790 to 300'


Bridged with 15 Sax Cement from 300 to 270' by Halliburton process

Filled heavy mud from 270 to 18'

Cemented with 5 Sax Cement from 18 to 8' (or bottom of cellar)

Welded steel cap over top of surface pipe in bottom of cellar

Cemented cellar with field rock & 5 Sax Cement

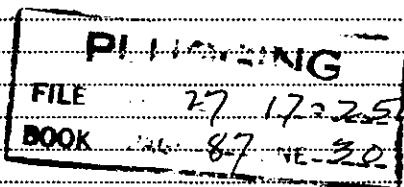

8-14-43

(If additional description is necessary, use BACK of this sheet)

Correspondence regarding this well should be addressed to Magnolia Petroleum Company
Address Box 888, Ellinwood, Kansas

STATE OF Kansas, COUNTY OF Barton, ss.

John F. Conley

(employee of owner) or (owner/operator)

being first duly sworn on oath, says: That I have knowledge of the facts, statements, and matters herein contained and the log of the above-described well as filed and that the same are true and correct. So help me God.

(Signature)

(Address)

SUBSCRIBED AND SWORN TO before me this 11 day of August, 1943

Notary Public.

My commission expires 10/13/45

Drilling Commenced 7/11/43
 Drilling Completed 8/11/43

Casing Record
 10-3/4" Set at 378 - Cem W/400 Sax

Cellar	0	10
shale & lime	10	402
10-3/4" Csg. set	378	
shale & shells	403	590
shale & red bed	590	1060
shale, sand, & shells	1060	1445
shale & shells	1445	1560
shale & lime	1560	1780
shale	1780	1960
shale & lime	1960	2195
shale	2195	2320
lime	2320	2400
lime & shale	2400	2490
shale	2490	2585
lime & shale	2585	2680
lime	2680	3170
lime & shale	3170	3320
lime	3320	3360
lime & shale	3360	3450
shale & broken lime	3450	3565
shale	3565	3605
lime	3605	4060
shale	4060	4155
lime	4155	4290
shale & lime	4290	4365
lime	4365	4398
Chert & lime	3298	4409
Cored 02 - 09 - 3" Rec. - No Oil Shows		
Top Mississippi	4406	
Cored 09 - 14 - 3" Rec. - No Oil Shows		
Mississippi lime	4406	4757
shale	4757	4762
Top Misener Sand	4762	
Misener Sand	4762	4774
Top Viola	4474	
Viola Lime	4474	4790
No Oil shows in any of above pays		
TD - SLM	4790	

Dry & Abandoned

27 17 25W
 87 30