


Give All Information Completely
Make Required Affidavit
Mail or Deliver Report to:
Conservation Division
State Corporation Commission
211 No. Broadway
Wichita, Kansas

WELL PLUGGING RECORD

NORTH

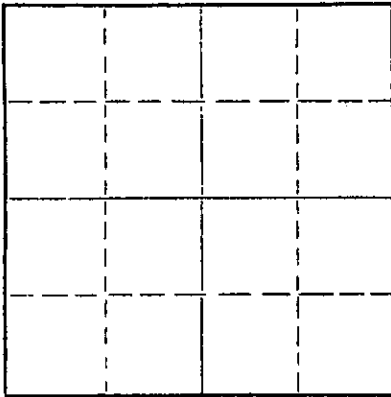

Locate well correctly on above
Section Plat

Tract _____ County. Sec. 25 Twp. 17S Rge. 25 (E) (W) _____
Location as "NE/CNWxSWx" or footage from lines W 1/2 SW NE
Lease Owner Barnett Oil Company
Lease Name Potter Well No. 2
Office Address 411 First National Building Wichita 2, Kansas
Character of Well (completed as Oil, Gas or Dry Hole) _____
Date well completed _____ 19____
Application for plugging filed _____ 19____
Application for plugging approved _____ 19____
Plugging commenced 1-27-64 19____
Plugging completed 1-29-64 19____
Reason for abandonment of well or producing formation Dry

If a producing well is abandoned, date of last production _____ 19____
Was permission obtained from the Conservation Division or its agents before plugging was commenced? Eldon Petty

Name of Conservation Agent who supervised plugging of this well Yes
Producing formation _____ Depth to top _____ Bottom _____ Total Depth of Well 4370 Feet
Show depth and thickness of all water, oil and gas formations.

OIL, GAS OR WATER RECORDS

CASING RECORD

FORMATION	CONTENT	FROM	TO	SIZE	PUT IN	PULLED OUT
				8 5/8	220	None
				5 1/2	None	3031

Describe in detail the manner in which the well was plugged, indicating where the mud fluid was placed and the method or methods used in introducing it into the hole. If cement or other plugs were used, state the character of same and depth placed, from _____ feet to _____ feet for each plug set.

Setting up unit. Cleaned out cellar.

Measured T. D. Sanded to 4320' and 4 sacks of cement. Rigging up jacks.
Working pipe. Shot at 3500'. Working pipe. Shot at 3003'. Working pipe.

Pulling pipe.

Pulling pipe.

Circulating mud. Spotted 50 sacks of cement.

RECEIVED
STATE CORPORATION COMMISSION

FEB 3 1964

CONSERVATION DIVISION
Wichita, Kansas

(If additional description is necessary, use BACK of this sheet)
Name of Plugging Contractor Forbes Casing Pulling, Inc.
Address P. O. Box 221 Great Bend, Kansas

STATE OF Kansas, COUNTY OF Barton, ss.
J. O. Forbes (employee of owner) or (owner or operator) of the above-described well, being first duly sworn on oath, says: That I have knowledge of the facts, statements, and matters herein contained and the log of the above-described well as filed and that the same are true and correct. So help me God.

(Signature) J. O. Forbes
P. O. Box 221 Great Bend, Kansas
(Address)

SUBSCRIBED AND SWORN TO before me this 31 day of January, 1964

My commission expires May 27, 1964

Notary Public.

15-135-00511-00-00

BARNETT OIL COMPANY
WELL LOG - POTTER NO. 2
A/C W/2 SW/4 NW/4 SEC. 25-178-25W
NESS COUNTY, KANSAS

DATE STARTED: 7/3/59

DATE ROTARY COMPLETED: 7/17/59

<u>FROM</u>	<u>TO</u>	<u>FORMATION</u>
0	105	Clay and shale
105	220	Shale and shells
220	610	Shale and clay
610	940	Shale and shells
940	975	Sand
975	1190	Shale and shells
1190	1450	Sand and shale
1450	1718	Shale and shells
1718	1745	Anhydrite
1745	2275	Shale and shells
2275	3815	Lime and shale
3815	4300	Lime
4300	4360	Lime and shale
4360	4448	Lime (T.D.)

Set 8 5/8", 28# used casing at 220'
with 125 sacks of cement.

Set 5 1/2", 15.50# new s.s. casing at 4447'
with 125 sacks of cement.

RECEIVED
STATE CORPORATION COMMISSION

FEB 5 1964

CONSERVATION DIVISION
Wichita, Kansas