


15-135-19091-0000

WELL PLUGGING RECORD

Give All Information Completely  
Make Required Affidavit  
Mail or Deliver Report to:  
Conservation Division  
State Corporation Commission  
211 No. Broadway  
Wichita, Kansas

Ness County, Sec. 30 Twp. 17S Rge. 25W (E) (W)

NORTH

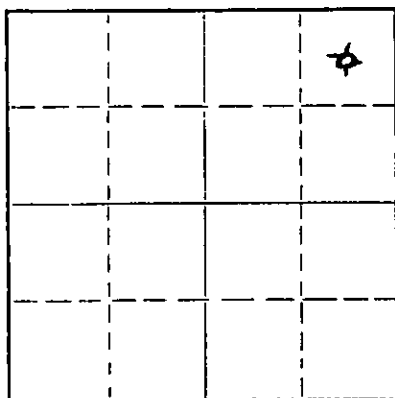

Locate well correctly on above Section Plat

Location as "NE/CNW/SW" or footage from lines NE/4 NE/4  
Lease Owner Walters Drilling Co.  
Lease Name KANSAS UNIVERSITY Well No. 1  
Office Address 510 Orpheum Building, Wichita, Kansas  
Character of Well (completed as Oil, Gas or Dry Hole) Dry Hole  
Date well completed February 12th 1963  
Application for plugging filed February 12th 1963  
Application for plugging approved February 12th 1963  
Plugging commenced February 12th 1963  
Plugging completed February 12th 1963  
Reason for abandonment of well or producing formation \_\_\_\_\_

If a producing well is abandoned, date of last production \_\_\_\_\_ 19\_\_\_\_  
Was permission obtained from the Conservation Division or its agents before plugging was commenced? Yes, verbal approval

Name of Conservation Agent who supervised plugging of this well Eldon Petty  
Producing formation Mississippian Depth to top \_\_\_\_\_ Bottom \_\_\_\_\_ Total Depth of Well 4480 Feet  
Show depth and thickness of all water, oil and gas formations.

OIL, GAS OR WATER RECORDS

CASING RECORD

FORMATION	CONTENT	FROM	TO	SIZE	PUT IN	PULLED OUT
				8-5/8"	111'	-0-

Describe in detail the manner in which the well was plugged, indicating where the mud fluid was placed and the method or methods used in introducing it into the hole. If cement or other plugs were used, state the character of same and depth placed, from \_\_\_\_\_ feet to \_\_\_\_\_ feet for each plug set.

Set first plug @ 660' with 20 sacks cement through drill pipe. Set second plug @ 180' with 20 sacks cement through drill pipe, set top plug at 40' with 10 sacks cement. Job complete at 10:00 AM

FEB 10 1963

(If additional description is necessary, use BACK of this sheet)

Name of Plugging Contractor Walters Drilling Co.  
Address 510 Orpheum Building, Wichita, Kansas

STATE OF KANSAS COUNTY OF SEDGWICK, ss.  
Robert F. Walters (employer, contractor) or (owner or operator) of the above-described well, being first duly sworn on oath, says: That I have knowledge of the facts, statements, and matters herein contained and the log of the above-described well as filed and that the same are true and correct. So help me God.

(Signature) Robert F. Walters  
ROBERT F. WALTERS, Partner  
510 Orpheum, Wichita, Kansas  
(Address)

SUBSCRIBED AND SWORN TO before me this 14th day of February, 1963

Velma L. Deines  
Velma L. Deines Notary Public.

My commission expires January 11th, 1967.



15-135-19091-0000

KANSAS UNIVERSITY #1

LOCATION: NE/4 NE/4 Section 30-17S-25W DATE SPUDDED: 1-31-63  
Ness County, Kansas ROTARY COMPLETION: 2-12-63

OPERATOR: WALTERS DRILLING CO.

CONTRACTOR: Walters Drilling Co.

SURFACE CASING: 8-5/8" set @ 111' w/90 sacks cement

OIL STRING: NONE

L O G

(Figures indicate bottom of formation)

Soil	0-30'
Post Rock	70'
Shale	112'
Shale & Shells	1205'
Blaine	1217'
Shale & Shells	1280'
Sand	1530'
Shale & Shells	1802'
Anhydrite	1835'
Shale & Shells	2430'
Lime & Shale	3925'
Lime	3990'
Lime & Shale	4110'
Lime	4150'
Lime & Shale	4420'
Shale & Dolomite	4435'
Dolomite	4480'
Total Depth	4480'

FEB 13 1963

The undersigned, Robert F. Walters, hereby certifies that the above log is a true and correct log of the formations encountered in drilling the above noted well as reflected by the Daily Drilling Reports.


WALTERS DRILLING CO.

By



ROBERT F. WALTERS, Partner

Subscribed and sworn to before me  
this 14th day of February, 1963.

  
Velma L. Deines, Notary Public

My commission expires January 11th, 1967.