


15-135-0023-0000

Give All Information Completely
Make Required Affidavit
Mail or Deliver Report to:
Conservation Division
State Corporation Commission
212 North Market, Insurance Bldg.
Wichita, Kansas

WELL PLUGGING RECORD

NORTH

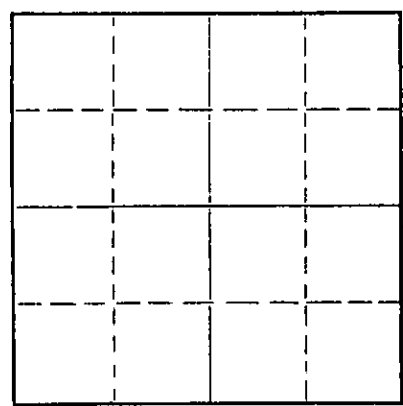

Locate well correctly on above Section Plat

Ness County. Sec. 30 Twp. 17S Rge. (E)25 (W)
Location as "NE/CNW&SW" or footage from lines C NW/4
Lease Owner Aladdin Petroleum Corporation
Lease Name Brecklein Well No. 1
Office Address 809 Petroleum Bldg., Wichita, Kansas
Character of Well (completed as Oil, Gas or Dry Hole) Dry Hole
Date well completed June 3 1962
Application for plugging filed July 25 1962
Application for plugging approved July 30 1962
Plugging commenced July 30 1962
Plugging completed August 3 1962
Reason for abandonment of well or producing formation Went to water

If a producing well is abandoned, date of last production 19____
Was permission obtained from the Conservation Division or its agents before plugging was commenced?

Name of Conservation Agent who supervised plugging of this well Eldon Petty Hays, Kansas
Producing formation _____ Depth to top _____ Bottom _____ Total Depth of Well 4,619 Feet
Show depth and thickness of all water, oil and gas formations.

OIL, GAS OR WATER RECORDS

CASING RECORD

FORMATION	CONTENT	FROM	TO	SIZE	PUT IN	PULLED OUT
				8 5/8	252	None
				5 1/2	4,588	3,580

Describe in detail the manner in which the well was plugged, indicating where the mud fluid was placed and the method or methods used in introducing it into the hole. If cement or other plugs were used, state the character of same and depth placed, from _____ feet to _____ feet for each plug set.

Mudded 4,370' to 600'
Rock bridge 600' to 580'
20 Sacks cement 580' to 520'
Mudded 520' to 170'
20 Sacks cement 170' to 110'
Mudded 110' to 35'
10 Sacks cement 35' to base of cellar

RECEIVED
STATE CORPORATION COMMISSION

8-16-62 AUG 1 1962

CONSERVATION DIVISION
WICHITA, KANSAS

(If additional description is necessary, use BACK of this sheet)
Name of Plugging Contractor Glenn & Smith Pipe Pulling Company
Address Ellinwood, Kansas

STATE OF Kansas, COUNTY OF Sedgwick, ss.
J. M. Johnson (employee of owner) or (owner or operator) of the above-described well, being first duly sworn on oath, says: That I have knowledge of the facts, statements, and matters herein contained and the log of the above-described well as filed and that the same are true and correct. So help me God.

(Signature) J. M. Johnson
809 Petroleum Building, Wichita, Kansas
(Address)

SUBSCRIBED AND SWORN TO before me this 15th day of August, 1962

Grace Sauder
Notary Public.

My commission expires December 11, 1965



15-135-00213-0000

BARNETT DRILLING, INC.
LOG OF BROCKLEIN NO. 1
A/C NW SE SEC. 30-17S-25W,
NESS COUNTY, KANSAS

Commenced: 5/13/62

Completed: 6/3/62

<u>Formation</u>	<u>From</u>	<u>To</u>	<u>Remarks</u>
Foot Rock	0	60	
Shale, Sand & Rock	60	163	
Sand & Shale	163	254	8-5/8" set @ 252' w/200 sacks RA-5.
Shale & Shells	254	365	
Sand & Shale	365	940	
Shale & Shells	940	1010	
Sand	1010	1060	
Red Bed & Shale	1060	1175	
Anhydrite	1175	1200	
Shale & Shells	1200	1710	
Anhydrite	1710	1735	
Shale w/Lime Streaks	1735	2030	
Shale & Lime	2030	2775	
Lime	2775	2840	
Shale & Lime	2840	3000	
Lime	3000	3275	
Lime & Shale	3275	3395	
Shale & Lime	3395	3490	
Lime & Shale	3490	3765	
Shale & Lime	3765	3855	
Lime	3855	4020	
Lime & Chert	4020	4052	
Lime & Shale	4052	4105	
Lime	4105	4145	
Chalky Lime & Shale	4145	4215	
Lime & Shale	4215	4236	
Lime & Chert	4236	4265	
Lime	4265	4315	
Lime & Shale	4315	4350	
Lime	4350	4400	
Lime & Shale	4400	4433	
Lime	4433	4606	
Chert & Lime	4606	4624	T.D. 5 1/2" O.D. J-55 Casing set at 4489' w/125 sacks cement.

RECEIVED
 STATE CORPORATION COMMISSION
 JUL 17 1962
 CONSERVATION DIVISION
 Wichita, Kansas

I, Jack S. Griggs, of Barnett Drilling, Inc., certify to the best of my knowledge and belief that the foregoing is a true and correct log of the Brocklein No. 1, located in the A/C NW SE of Section 30-17S-25W, Ness County, Kansas.

Jack S. Griggs

Subscribed and sworn to by and before me in and for the County of Sedgwick, State of Kansas, on this 11th day of July, 1962.

Louise K. Whitted
 Louise K. Whitted - Notary Public

My Commission expires November 26, 1962.