


15-135-20830-0000

STATE OF KANSAS  
STATE CORPORATION COMMISSION

Form CP-4

Give All Information Completely  
Make Required Affidavit  
Mail or Deliver Report to:  
Conservation Division  
State Corporation Commission  
P. O. Box 17027  
Wichita, Kansas 67217  
NORTH

WELL PLUGGING RECORD

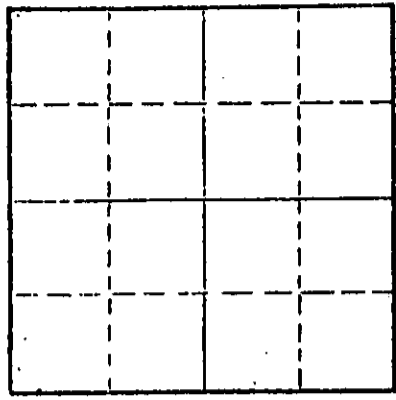

Locate well correctly on above  
Section Plat

Ness County, Sec. 30 Twp. 17S Rge. (E)25W.(W)  
Location as "NE/CNW/KSW" or footage from lines C NE NW  
Lease Owner Bankoff Oil Company  
Lease Name Popp 'A' Well No. 1  
Office Address P.O. Drawer 2479, Tulsa, Okla  
Character of Well (completed as Oil, Gas or Dry Hole) Dry Hole  
Date well completed 12-18-1973  
Application for plugging filed 12-18-73  
Application for plugging approved 12-18-1973  
Plugging commenced 12-18-1973  
Plugging completed 12-18-1973  
Reason for abandonment of well or producing formation No commercial quantities of oil or gas encountered  
If a producing well is abandoned, date of last production 19  
Was permission obtained from the Conservation Division or its agents before plugging was commenced? Yes

Name of Conservation Agent who supervised plugging of this well Leo Massey  
Producing formation \_\_\_\_\_ Depth to top \_\_\_\_\_ Bottom \_\_\_\_\_ Total Depth of Well 4457 Feet  
Show depth and thickness of all water, oil and gas formations.

OIL, GAS OR WATER RECORDS

CASING RECORD

FORMATION	CONTENT	FROM	TO	SIZE	PUT IN	PULLED OUT
Surface Hole	Water	Surface	258	8-5/8"	250	None

Describe in detail the manner in which the well was plugged, indicating where the mud fluid was placed and the method or methods used in introducing it into the hole. If cement or other plugs were used, state the character of same and depth placed, from \_\_\_\_\_ feet to \_\_\_\_\_ feet for each plug set.

Fluid to 720, plug, 70 sx cement;  
Fluid to 240, plug, 30 sx cement;  
Fluid to 40, plug, 1/2 sx hulls, 10 sx cement;

RECEIVED  
STATE CORPORATION COMMISSION  
JAN 15 1974  
CONSERVATION DIVISION  
Wichita, Kansas

(If additional description is necessary, use BACK of this sheet)  
Name of Plugging Contractor D N B DRILLING, INC.  
Address 701 First Nat'l Bldg., Wichita, Kansas 67202

STATE OF KANSAS COUNTY OF \_\_\_\_\_ ss.  
JAMES L. DONELSON (employee of owner) or (owner or operator) of the above-described well, being first duly sworn on oath, says: That I have knowledge of the facts, statements, and matters herein contained and the log of the above-described well as filed and that the same are true and correct. So help me God.

(Signature) *James L. Donelson*  
701 First Nat'l Bldg., Wichita, Ks.  
(Address)

Subscribed and sworn to before me this 11th day of January 1974

*Ella Priess*  
Notary Public.

My commission expires August 25, 1976 Ella Priess

Ella Priess  
STATE NOTARY PUBLIC  
Sedgwick County, Kansas  
My Com. Expires Aug. 25, 1976

K-135-28830-0000

DRILLERS' LOG

BANKOFF OIL COMPANY  
No. 1 Popp 'A'  
C NE NW, Sec. 30-178-25W  
Ness County, Kansas

Elevation: 2487 K.B.

Commenced: 12-10-73  
Completed: 12-10-73

Surface Casing: 250' of  
8-5/8" cemented w/175 sx  
common cement, 2% gel, 38  
cc. 12-11-73.

FORMATION

DEPTH

Surface Hole	0 - 258
Sand & Shale	258-975
Shale	975 - 1205
Blaine Anhydrite	1205 - 1222
Shale	1222 - 1300
Sand	1300 - 1500
Red Bed	1500 - 1725
Shale	1725 - 1806
Stone Corral Anhy.	1806 - 1839
Shale	1839 - 2200
Shale & Lime	2200 - 2470
Lime & Shale	2470 - 3785
Lime	3785 - 4457 T.D.

RECEIVED  
STATE CORPORATION COMMISSION  
JAN 15 1974  
CONSERVATION DIVISION  
Wichita, Kansas

I do hereby certify that the foregoing statements are true and correct to the best of my knowledge and belief.

DNB DRILLING, INC.

*James L. Donelson*  
JAMES L. DONELSON

STATE OF KANSAS: ss:

Subscribed and sworn to before me, the undersigned, a Notary Public in and for said state, this 11th day of January 1974.

My Commission Expires:  
August 25, 1976

*Ella Priess*  
Ella Priess, Notary Public

*Ella Priess*  
STATE NOTARY PUBLIC  
Sedgwick County, Kansas  
My Com. Expires Aug. 25, 1976