

STATE OF KANSAS
STATE CORPORATION COMMISSION

WELL PLUGGING RECORD

Give All Information Completely
Make Required Affidavit
Mail or Deliver Report to:
Conservation Division
State Corporation Commission
212 North Market, Insurance Bldg.
Wichita, Kansas

Kearny County. Sec. 5 Twp. 25S Rge. (E) 35 (W)

Location as "NE/CNW/SW" or footage from lines NE/4 NE/4

Lease Owner Greenland Drilling Company

Lease Name Roderick Well No. 1

Office Address 4722 Broadway, Kansas City, Mo.

Character of Well (completed as Oil, Gas or Dry Hole) Dry Hole

Date well completed 12-11 1959

Application for plugging filed 12-11 1959

Application for plugging approved 12-11 1959


Plugging commenced 12-11 1959

Plugging completed 12-11 1959

Reason for abandonment of well or producing formation Dry Hole

If a producing well is abandoned, date of last production _____ 19____

Was permission obtained from the Conservation Division or its agents before plugging was commenced? Yes

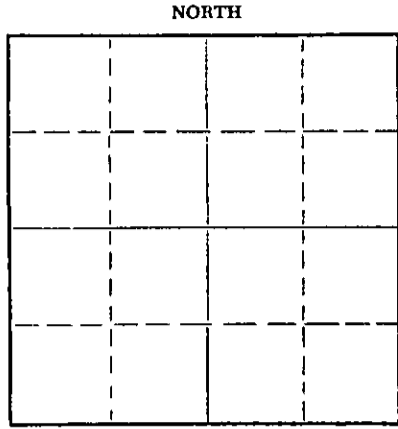

Locate well correctly on above Section Plat

Name of Conservation Agent who supervised plugging of this well _____

Producing formation _____ Depth to top _____ Bottom _____ Total Depth of Well 4955 Feet

Show depth and thickness of all water, oil and gas formations.

OIL, GAS OR WATER RECORDS

CASING RECORD

FORMATION	CONTENT	FROM	TO	SIZE	PUT IN	PULLED OUT
				8-5/8"	594'	None

Describe in detail the manner in which the well was plugged, indicating where the mud fluid was placed and the method or methods used in introducing it into the hole. If cement or other plugs were used, state the character of same and depth placed, from _____ feet to _____ feet for each plug set.

Plug with 100 sacks cement through drill pipe at 2400'
Plug and 20 sacks cement at 540'
Another plug and 10 sacks cement at 35'.

(If additional description is necessary, use BACK of this sheet)

Name of Plugging Contractor Greenland Drilling Company

Address 4722 Broadway, Kansas City 12, Mo.

STATE OF Kansas, COUNTY OF Sedgwick, ss.
Oscar Bridge, Vice-President (employee of owner) or (owner or operator) of the above-described

well, being first duly sworn on oath, says: That I have knowledge of the facts, statements, and matters herein contained and the log of the above-described well as filed and that the same are true and correct. So help me God.

(Signature) Oscar Bridge
Oscar Bridge, Vice-President
4722 Broadway, Kansas City, Mo.
(Address)

SUBSCRIBED AND SWORN TO before me this 15th day of December, 1959

Verdina B. Rutledge
Notary Public.

My commission expires 3-15-60



15-093-00011-0000

GREENLAND DRILLING CO.

WELL LOG

Company: GREENLAND DRILLING COMPANY

Sec. 5 Twp. 25S Rge. 35W
Location: NE/4 NE/4
Kearny County, Kansas

Farm: RODERICK No. 1

Commenced: 11-20-59

Completed: 12-11-59

Total Depth: 4955

Contractor: GREENLAND DRILLING COMPANY

Casing: 8-5/8" 594'
5-1/2" —

Elevation: 2975 RB
Production: D & A

Figures Indicate Bottom of Formations

330	Sand & clay	TOPS: (Schlumberger Log)
425	Shale	Herington 2370
535	Sand & shale	Upper Krider 2405
574	Shale	Lower Krider 2418
960	Shale	Winfield 2457
1260	Red bed	Upper Ft. Riley 2514
1300	Anhydrite	Lower Ft. Riley 2573
1370	Red bed	Council Grove 2684
1585	Sand & red bed	Marmaton 4287
1825	Red bed & sand	Cherokee 4414
1870	Lime & shale	Morrow 4675
2105	Shale & sand - lime	Ste. Gen. 4811
2185	Lime & shale	St. Louis 4885
2404	Lime & shale	Spergen 4926
2517	Lime & shale - sand	
2630	Lime & shale	
2710	Lime	
2830	Lime & shale	
2900	Lime	
2965	Lime & shale	
3160	Lime	
3343	Lime & shale	
3385	Lime	
3423	Lime & shale	
3579	Lime	
3624	Lime & shale	
3750	Lime	
3778	Lime & shale	
4260	Lime	
4283	Lime & shale	
4305	Lime	
4460	Lime & shale	
4592	Lime	
4619	Lime & shale	
4657	Lime	
4679	Lime, chert & sand	
4703	Sandy shale	
4752	Shale & lime	
4774	Lime & shale	
4806	Shale & sandy shale	
4817	St. Gen. Miss.	
4955	Lime	
4955	RTD	

STATE OF KANSAS, COUNTY OF SEDGWICK, ss:

I, Oscar Bridge, of the Greenland Drilling Company, upon oath state that the above and foregoing is a true and correct copy of the log of the #1 Roderick well.

Oscar Bridge, Vice-President

Subscribed and sworn to before me this 15th day of December, 1959.

Verdina B. Rutledge
Verdina B. Rutledge, Notary Public

My commission expires March 15, 1960.