


STATE OF KANSAS
STATE CORPORATION COMMISSION

Give All Information Completely
Make Required Affidavit
Mail or Deliver Report to:
Conservation Division
State Corporation Commission
211 No. Broadway
Wichita, Kansas

WELL PLUGGING RECORD

NORTH

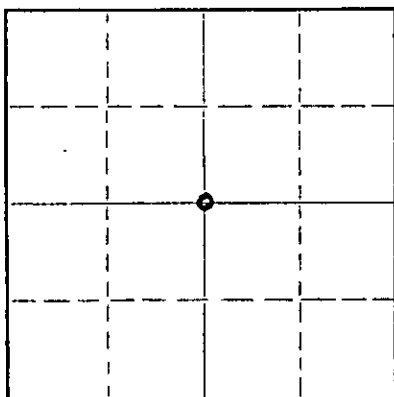

Locate well correctly on above
Section Plat

KEARNY

County. Sec. 5 Twp. 25 Rge. 35 (E) W (W)Location as "NE/CNW/SW" or footage from lines CENTER OF SECTIONLease Owner KANSAS NATURAL GAS INC.Lease Name FROSTWell No. 1Office Address BOX 599 HAYS, KANSASCharacter of Well (completed as Oil, Gas or Dry Hole) GASDate well completed 1-20 1963Application for plugging filed 9-30 1963Application for plugging approved 9-30 1963Plugging commenced 10-11 1963Plugging completed 10-11 1963Reason for abandonment of well or producing formation CASING PROBLEMSIf a producing well is abandoned, date of last production AUGUST 1963Was permission obtained from the Conservation Division or its agents before plugging was commenced? YESName of Conservation Agent who supervised plugging of this well HUGH SCOTT SHIBLETTE, KANSASProducing formation HUGOTON Depth to top 2415' Bottom 2652' Total Depth of Well 2652' Feet

Show depth and thickness of all water, oil and gas formations.

OIL, GAS OR WATER RECORDS

CASING RECORD

FORMATION	CONTENT	FROM	TO	SIZE	PUT IN	PULLED OUT
				10 3/4"	600'	None
				7"	2415'	None
				5 1/2"	238'	None (Liner)

Describe in detail the manner in which the well was plugged, indicating where the mud fluid was placed and the method or methods used in introducing it into the hole. If cement or other plugs were used, state the character of same and depth placed, from _____ feet to _____ feet for each plug set.

6 sacks mud and 2 sacks Halls mixed

2652' to 1402' 250 sacks common cement

1402' to 1250' Mud

1250' to zero 250 sacks common cement

Dug 3' below ground level and cut off casing and welded on cap.

RECEIVED
STATE CORPORATION COMMISSION

OCT 17 1963

1963
CONSERVATION DIVISION
Wichita, Kansas

(If additional description is necessary, use BACK of this sheet)

Name of Plugging Contractor Sun Cementing CompanyAddress Liberal, KansasSTATE OF Kansas COUNTY OF Lincoln, ss.

Ralph Hinkle (employee of owner) or (owner or operator) of the above-described well, being first duly sworn on oath, says: That I have knowledge of the facts, statements, and matters herein contained and the log of the above-described well as filed and that the same are true and correct. So help me God.

(Signature) Ralph HinkleBox 537 Garden City, Mo.

(Address)

SUBSCRIBED AND SWORN TO before me this 15th day of Oct, 1963

My commission expires

11-24-63

Notary Public.