


K

WELL PLUGGING RECORD

Give All Information Completely
Make Required Affidavit
Mail or Deliver Report to:
Conservation Division
State Corporation Commission
211 No. Broadway
Wichita, Kansas

Kearney County, Sec. 19 Twp. 25 Rge. 36W (E) (W)
Location as "NE/CNWxSWx" or footage from lines C of SE 1/4 SW 1/4 AUB REC
Lease Owner W. B. Osborn Operator
Lease Name Johnson Well No. 6
Office Address Box 6767, San Antonio, Texas
Character of Well (completed as Oil, Gas or Dry Hole)
Date well completed 2-10-62 19
Application for plugging filed By Phone Feb. 10, 1962 19
Application for plugging approved By Phone Feb. 10, 1962 19
Plugging commenced 2-10-62 19
Plugging completed 2-10-62 19
Reason for abandonment of well or producing formation Dry Hole

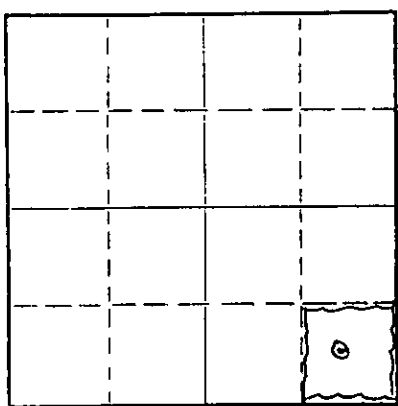

Locate well correctly on above Section Flat

If a producing well is abandoned, date of last production 19
Was permission obtained from the Conservation Division or its agents before plugging was commenced? By Phone

Name of Conservation Agent who supervised plugging of this well W. L. Lackamp, Jr.
Producing formation None Depth to top Bottom Total Depth of Well 4813 Feet
Show depth and thickness of all water, oil and gas formations.

OIL, GAS OR WATER RECORDS

CASING RECORD

Table with 7 columns: FORMATION, CONTENT, FROM, TO, SIZE, PUT IN, PULLED OUT. Row 1: Surface Sands, Surface, 560', 8-5/8, 673', 83'. Row 2: Drillers Log Attached.

Describe in detail the manner in which the well was plugged, indicating where the mud fluid was placed and the method or methods used in introducing it into the hole. If cement or other plugs were used, state the character of same and depth placed, from feet to feet for each plug set.

Well was drilled to a depth of 4813' when circulation was lost. After regaining circulation 3 times and being unable to make more hole without losing returns, the well was temporarily abandoned on Dec. 29, 1961.

Operations were resumed on Feb. 2, 1962 and an attempt was made to washover and remove the 8-5/8 surface casing in order to set 8-5/8 to 1900'. After removing 83 ft. of the 8-5/8, we were unable to washover the remaining pipe. An attempt was made to clean out below the surface pipe, but we were unable to stay in the old hole. On the 10th of February a 50 sx. cement plug was spotted thru the drill pipe from the bottom of the surface casing back to 530 ft. and a 100 sx. plug was spotted thru the drill pipe from 85 ft. back to the surface of the ground. Hole was left with heavy rotary mud from T.D. back to the bottom of the surface casing.

RECEIVED
STATE CORPORATION COMMISSION
MAR 21 1962
CONSERVATION DIVISION
Wichita, Kansas

(If additional description is necessary, use BACK of this sheet)

Name of Plugging Contractor Plugged with rotary rig - Braden Drilling Co.
Address 1206 Union National Building, Wichita, Kansas

STATE OF TEXAS, COUNTY OF BEXAR, ss.
Jack Watson, Jr. (employee of owner) or (owner or operator) of the above-described well, being first duly sworn on oath, says: That I have knowledge of the facts, statements, and matters herein contained and the log of the above-described well as filed and that the same are true and correct. So help me God.

(Signature) Jack Watson, Jr.
Box 6767, San Antonio, Texas
(Address)

SUBSCRIBED AND SWORN TO before me this 19th day of March, 19 62

My commission expires 6-1-63

Doris I. Harper
Notary Public.

DORIS I. HARPER
Notary Public, Bexar County, Texas

DRILLER'S LOG

W. B. Osborn Operator
JOHNSON #6
SE SW Sec. 19-25-36W
Kearny County, Kansas

Commenced: December 3, 1961

Completed: December 29, 1961

Set 8 5/8" at 673 and cemented
with 450 sacks cement.

Surface sand	560'
Shale and shells	680
Shale, redbed and sand	1200
Shale, shells, redbed	1320
Redbed and sand	1450
Sand	1765
Shale and shells	2140
Lime and shells	2360
Lime and shale	3320
Lime and shale with chalk	3550
Lime with chalk	4250
Lime	4630
Shale and Lime	4790
Lime	4813 Total Depth

RECEIVED
STATE CORPORATION COMMISSION
MAR 21 1962
CONSERVATION DIVISION
Wichita, Kansas

I hereby certify that this is a true and correct log of the above captioned well, as shown by the daily drilling reports.

BRADEN DRILLING, INC.

By *F. M. Callaway*
F. M. Callaway

Subscribed and sworn to before me this 3rd day of January, 1962.

My commission expires March 21, 1962.

Helen Schults
Helen Schults, Notary Public