


Give All Information Completely
Make Required Affidavit
Mail or Deliver Report to:
Conservation Division
State Corporation Commission
211 No. Broadway
Wichita, Kansas

WELL PLUGGING RECORD

15-093-00030-0000

NORTH

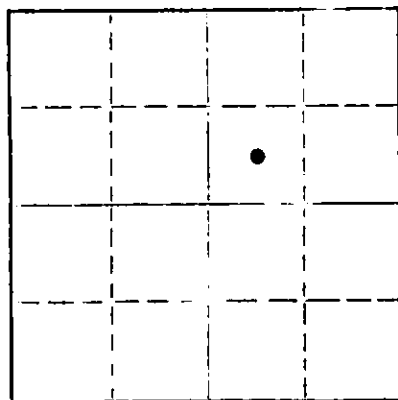

Locate well correctly on above
Section Plat

Kearney County, Sec. 18 Twp. 26S Rge. 36 (E) (W)

Location as "NE/CNW/SW" or footage from lines Center of SW NE 1/4

Lease Owner Helmerich & Payne, Inc. (Originally: Braden Drilling, Inc. et al)

Lease Name TOOMBS Well No. 1

Office Address Box 255, Garden City, Kansas

Character of Well (completed as Oil, Gas or Dry Hole) Dry Hole

Date well completed April 19, 1962

Application for plugging filed April 6, 1962

Application for plugging approved April 18, 1962

Plugging commenced April 19, 1962

Plugging completed April 19, 1962

Reason for abandonment of well or producing formation Dry hole

If a producing well is abandoned, date of last production - 19

Was permission obtained from the Conservation Division or its agents before plugging was commenced? Yes

Name of Conservation Agent who supervised plugging of this well Mr. Victor Simoncic

Producing formation none Depth to top - Bottom - Total Depth of Well 5416 Feet

Show depth and thickness of all water, oil and gas formations.

OIL, GAS OR WATER RECORDS

CASING RECORD

| FORMATION | CONTENT | FROM | TO | SIZE | PUT IN | PULLED OUT |
|---------------|-------------------|------|------|---------|--------|------------|
| Council Grove | No Show | 3018 | 3022 | 10-3/4" | 563 | 0 |
| " | " | 2854 | 2856 | | | |
| " | " | 2798 | 2802 | 2-7/8" | 3100 | 1800 |
| " | " | 2779 | 2785 | | | |
| " | Small show of gas | 2740 | 2748 | | | |

(No shows in other formations)

Describe in detail the manner in which the well was plugged, indicating where the mud fluid was placed and the method or methods used in introducing it into the hole. If cement or other plugs were used, state the character of same and depth placed, from feet to feet for each plug set.

Plugged back from total depth for completion attempt in Council Grove in following manner:

5416-3691: Heavy drilling mud.

3691-3127: 100 sacks of Pozmix. (2-7/8" Tubing set at 3100' & cemented w/350 sacks pozmix.)

After completion attempt failure in Council Grove:

Mixed & pumped in 12 sacks of cement - balanced plug in @ 2740-2385. Let set one hour - plug did not move. Shot 2-7/8" tubing loose at 1800' and pulled up to 600'. Circulated mud - spotted 50 sack cement plug down 2-7/8" tubing from 600-475. Pulled balance of 2-7/8" tubing - set rock bridge at 25' - mixed and put in 10 sacks of cement from 25' to 0'. Imbedded 4 1/2" csg. w/well identification sign in cement in surface casing - length of pipe extending 4' above ground level. Summary: 2740-2385: 12 sacks of cement plug (Top most perforations at: 2740)

2385-600 : Heavy drilling mud.

600-475 : 50 sack cement plug. (Bottom of surface csg: 563')

475-25 : Heavy drilling mud.

25-0 : 10 sack cement plug.

STATE OF KANSAS
CONSERVATION COMMISSION

APR 19 1962

(If additional description is necessary, use BACK of this sheet)

CONSERVATION DIVISION

Name of Plugging Contractor Ace Pipe Pulling Company

Address P. O. Box 304, Great Bend, Kansas

STATE OF Kansas, COUNTY OF Finney, ss.

T. E. Mort

(employee of owner) or (owner) of the above-described well, being first duly sworn on oath, says: That I have knowledge of the facts, statements, and matters herein contained and the log of the above-described well as filed and that the same are true and correct. So help me God.

(Signature) T. E. Mort

P. O. Box 255, Garden City, Kansas

(Address)

SUBSCRIBED AND SWORN TO before me this 20th day of April, 1962

Robert N. Boyd

Notary Public.

My commission expires July 1, 1964

STATE

15-093-00030-0000

DRILLER'S LOG

Helmerich & Payne Inc.
 Braden Drilling, Inc. et al
 TOWNS #1
 SW/4 NE/4 Sec. 18-26S-36W
 Kearny County, Kansas

Commenced: August 31, 1961

Completed: October 8, 1961

Set 10 3/4" surface casing at 563'
 and cemented with 425 sacks cement.

| | |
|---------------------------------|------------------|
| Sand | 70 ft. |
| Sand and gravel | 302 |
| Clay and shale | 400 |
| Shale shells, hard sand | 565 |
| Shale shells and sand stream | 880 |
| Shale and sand | 1330 |
| lime | 1375 |
| Sand and redbed | 1425 |
| Sand | 1680 |
| Shale and shells | 2220 |
| Shale and lime | 3347 |
| Lime and shale w/chalk | 3440 |
| lime and shale | 3545 |
| lime | 3655 |
| Lime w/chalk | 3770 |
| lime | 4055 |
| lime and shale | 4158 |
| lime | 4775 |
| lime and shale | 5030 |
| Shale | 5100 |
| Sand | 5129 |
| Shale and lime | 5167 |
| lime | 5416 Total Depth |

RECEIVED
 STATE CORPORATION COMMISSION

MAY 15 1962

CONSERVATION DIVISION
 Wichita, Kansas

I hereby certify that this is a true and correct log of the above
 captioned well, as shown by the daily drilling reports.

F. M. Galloway
 F. M. Galloway

Subscribed and sworn to before me this 18th day of October, 1961.

My commission expires March 21, 1962.

Helen Schultz
 Helen Schultz, Notary Public