

15-135-20988-0000


STATE OF KANSAS
STATE CORPORATION COMMISSION

Form CP-4

WELL PLUGGING RECORD

Give All Information Completely
Make Required Affidavit
Mail or Deliver Report to:
Conservation Division
State Corporation Commission
P. O. Box 17027
Wichita, Kansas 67217
NORTH

Ness County, Sec. 21 Twp. 17S Rge. (E) 25 (W)
Location as "NE/CNW&SW" or footage from lines C/NE NW
Lease Owner Patrick Petroleum Corporation
Lease Name Shearer Well No. 1
Office Address Suite 414, 200 E. 1st, Wichita, Kansas 67202
Character of Well (completed as Oil, Gas or Dry Hole) Dry Hole
Date well completed March 30 19 75
Application for plugging filed March 30 19 75
Application for plugging approved March 30 19 75
Plugging commenced March 30 19 75
Plugging completed March 30 19 75
Reason for abandonment of well or producing formation Dry Hole

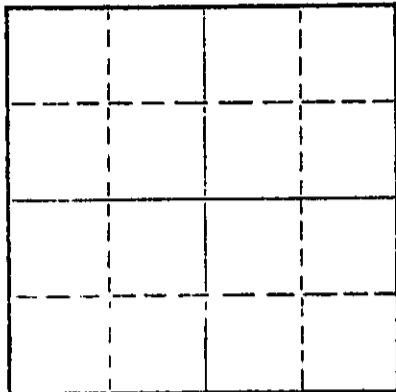

Locate well correctly on above Section Plat

If a producing well is abandoned, date of last production 19
Was permission obtained from the Conservation Division or its agents before plugging was commenced? Yes

Name of Conservation Agent who supervised plugging of this well Leo Massey, Hays, Kansas
Producing formation Depth to top Bottom Total Depth of Well 4500 Feet
Show depth and thickness of all water, oil and gas formations.

OIL, GAS OR WATER RECORDS

CASING RECORD

FORMATION	CONTENT	FROM	TO	SIZE	PUT IN	PULLED OUT
	8-5/8"	0'	293'			

Describe in detail the manner in which the well was plugged, indicating where the mud fluid was placed and the method or methods used in introducing it into the hole. If cement or other plugs were used, state the character of same and depth placed, from feet to feet for each plug set.

Hole plugged as follows: Plugged at 720' with 70 sacks of 50-50 pozmix & 6% gel; plugged at 240' with 20 sacks of 50-50 pozmix & 6% gel; plugged at 40' with 10 sacks of 50-50 pozmix and 6% gel. Plug down at 2:45 P. M. March 30, 1975.

RECEIVED
STATE CORPORATION COMMISSION

1977 8/18/75


CONSERVATION DIVISION
Wichita, Kansas

(If additional description is necessary, use BACK of this sheet)
Name of Plugging Contractor Strata Drilling Company
Address P. O. Box 355, Great Bend, Kansas 67530

STATE OF KANSAS, COUNTY OF BARTON, ss.
Kenneth J. Link (employee or owner) of the above-described well, being first duly sworn on oath, says: That I have knowledge of the facts, statements, and matters herein contained and the log of the above-described well as filed and that the same are true and correct. So help me God.

(Signature) Kenneth J. Link
Kenneth J. Link, President
P. O. Box 355, Great Bend, Kansas 67530
(Address)

Subscribed AND Sworn to before me this 1st day of April, 19 75

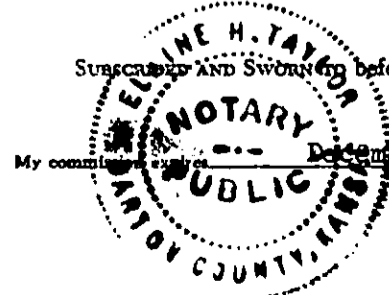

My commission expires December 14, 1977
Elaine H. Taylor Notary Public

D R I L L E R S L O G

#1 Shearer

CASING: 287.48' of used 8-5/8" surface casing.	COMPANY: Patrick Petroleum Corporation	DESCRIPTION: C/NE NW Section 21-17S-25W Ness County, Kansas
	CONTRACTOR: Strata Drilling Company	
TOTAL DEPTH: 4500'	COMMENCED: March 21, 1975	
	COMPLETED: March 30, 1975	

D. & A.

<u>FORMATION</u>	<u>FROM</u>	<u>TO</u>	<u>REMARKS</u>
Rock	0	40	Ran 287.48' of used 8-5/8" surface casing; set and cemented at 293' with 175 sacks of common cement, 2% gel and 3% C. C. Plug down at 5:00 A. M. March 22, 1975.
Rock, Sand & Shale	40	310	
Shale	310	355	
Shale & Shells	355	1000	
Sand, Shale & Shells	1000	1627	
Lime & Shale	1627	1955	
Shale w/Lime Streaks	1955	2620	
Lime & Shale	2620	4230	
Lime	4230	4290	
Lime & Shale	4290	4500	

ROTARY TOTAL DEPTH: 4500'

Ran Drill Stem Tests.

Ran Electric Log.

D. & A.

Hole plugged as follows: Plugged at 720 with 70 sacks of 50-50 pozmix & 6% gel; plugged at 240' with 20 sacks of 50-50 pozmix & 6% gel; plugged at 40' with 10 sacks of 50-50 pozmix and 6% gel. Plug down at 2:45 P. M. March 30, 1975.

RECEIVED
 STATE CORPORATION COMMISSION
 APR 8 1975
 CONSERVATION DIVISION
 Wichita, Kansas

STATE OF KANSAS)
) ss.
 COUNTY OF BARTON)


I certify that this is a true and correct copy of the above log to the best of my knowledge.

STRATA DRILLING COMPANY

Kenneth J. Link
 Kenneth J. Link, President

Subscribed and sworn to before me this 1st day of April, 1975.

My Commission Expires:

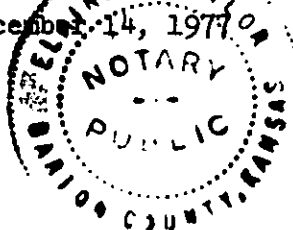December 14, 1977


Elaine H. Taylor
 Elaine H. Taylor, Notary Public