

STATE OF KANSAS
STATE CORPORATION COMMISSION

WELL PLUGGING RECORD

Give All Information Completely
Make Required Affidavit
Mail or Deliver Report to
Conservation Division
State Corporation Comm.
245 North Water
Wichita, KS 67202

Ness County, Sec. 22 Twp. 17S Rge. 25W E/W
Location as "NE/CNW 1/4 SW 1/4" or footage from lines
C SE SW


Lease Owner Reed Oil Company
Lease Name Shearer Well No. 1
Office Address P. O. Box 2, Chanute, Kansas 66720
Character of Well (Completed as Oil, Gas or Dry Hole)
dry hole

Date Well completed September 2, 1980 19
Application for plugging filed September 2, 1980 19
Application for plugging approved September 2, 1980 19
Plugging commenced September 2, 1980 19
Plugging completed September 2, 1980 19
Reason for abandonment of well or producing formation
dry hole

If a producing well is abandoned, date of last production 19

Was permission obtained from the Conservation Division or its agents before plugging was commenced? yes

Name of Conservation Agent who supervised plugging of this well Marion Schmidt
Producing formation Depth to top Bottom Total Depth of Well 4500'
Show depth and thickness of all water, oil and gas formations.

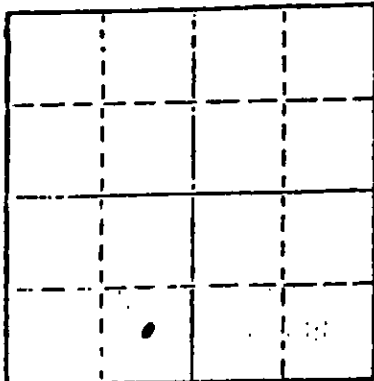

Locate well correctly on above Section Plot

OIL, GAS OR WATER RECORDS

CASING RECORD

FORMATION	CONTENT	FROM	TO	SIZE	PUT IN	PULLED OUT

Describe in detail the manner in which the well was plugged, indicating where the mud fluid was placed and the method or methods used in introducing it into the hold. If cement or other plugs were used, state the character of same and depth placed, from feet to feet for each plug set.

Hole plugged with 50-50 pozmix, 6% gel, as follows:
70 sacks @ 1050', 25 sacks at 330', hulls and
10 sacks at 40', 3 sacks in rathole, 2 sacks in
mousehole. Plugging completed at 5:00 a.m.,
September 2, 1980.

(If additional description is necessary, use BACK of this sheet)

Name of Plugging Contractor Strata Drilling Company

STATE OF KANSAS COUNTY OF BARTON, ss.
Charles W. Steincamp (employee of owner) or (owner or operator)
of the above-described well, being first duly sworn on oath, says: That I have knowledge of the facts, statements, and matters herein contained and the log of the above-described well as filed and that the same are true and correct. So help me God.

(Signature) Charles W. Steincamp
P. O. Box 355, Great Bend, Kansas 67530
(Address)

SUBSCRIBED AND SWORN TO before me this 10th day of September, 1980.

Loneita Barry
Loneita Barry Notary Public.

My commission expires 3-28-84.



RECEIVED
STATE CORPORATION COMMISSION

SEP 2 1980

CONSERVATION DIVISION
Wichita, Kansas

D R I L L E R S L O G

#1 Shearer

CASING RECORD: 8 jts. used 24# 8-5/8" surface casing	COMPANY: Reed Oil Company	DESCRIPTION: C SE SW Section 22-17S-25W Ness County, Kansas
TOTAL ROTARY DEPTH: 4500'	CONTRACTOR: Strata Drilling Company	ELEVATION: 2461' GL
	COMMENCED: August 27, 1980	
	COMPLETED: September 2, 1980	

<u>FORMATION</u>	<u>FROM</u>	<u>TO</u>	<u>REMARKS</u>	
Surface soil, shale	0	358	Ran 346' used 24# 8-5/8" surface casing; set and cemented at 351' with 200 sacks common cement, 2% gel, 3% C.C. Cement circulated. Plug down at 11:30 p.m., August 27, 1980.	
Shale, sand, shale	358	1788		
Anhydrite	1788	1817		
Shale	1817	2355		
Lime and shale	2355	4065		
Lime	4065	4335		
Lime and shale	4355	4440		
Lime	4440	4500		
				Hole plugged with 50-50 pozmix, 6% gel, as follows: 70 sacks @ 1050', 25 sacks at 330', hulls and 10 sacks at 40', 3 sacks in rathole, 2 sacks in mousehole. Plugging completed at 5:00 a.m., September 2, 1980.

STATE OF KANSAS)
)ss
COUNTY OF BARTON)

I certify that this is a true and correct copy of the above log to the best of my knowledge.

STRATA DRILLING COMPANY

Charles W. Steincamp
Charles W. Steincamp

Subscribed and sworn to before me this 10th day of September, 1980.

My appointment expires 3-28-84.

Loneita Barry
Loneita Barry, Notary Public

