


WELL PLUGGING RECORD

Give All Information Completely
Make Required Affidavit
Mail or Deliver Report to:
Conservation Division
State Corporation Commission
212 North Market, Insurance Bldg.
Wichita, Kansas

Ness County, Sec. 20 Twp. 17 Rge. 25 ~~25~~ (W)
Location as "NE/CNW/SW" or footage from lines. C NE/4 SE/4
Lease Owner Barnett Oil Company
Lease Name Elmore Well No. 1
Office Address 411 First Nat'l Bank Bldg., Wichita, Kansas
Character of Well (completed as Oil, Gas or Dry Hole) Dry Hole
Date well completed July 9, 1962
Application for plugging filed July 9, (verbal) 62
Application for plugging approved July 9, 1962
Plugging commenced July 9, 1962
Plugging completed July 9, 1962
Reason for abandonment of well or producing formation Dry Hole

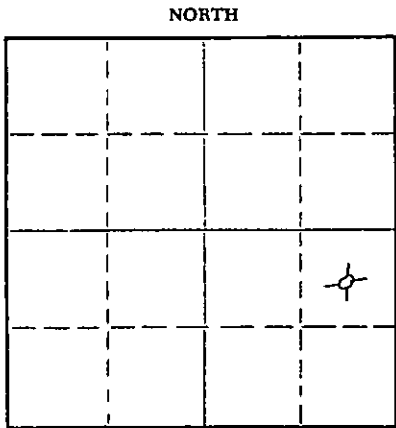

Locate well correctly on above Section Plat

If a producing well is abandoned, date of last production 19
Was permission obtained from the Conservation Division or its agents before plugging was commenced? Yes

Name of Conservation Agent who supervised plugging of this well Eldon Petty
Producing formation Mississippian Depth to top 4425 Bottom - - Total Depth of Well 4451 Feet
Show depth and thickness of all water, oil and gas formations.

OIL, GAS OR WATER RECORDS

CASING RECORD

FORMATION	CONTENT	FROM	TO	SIZE	PUT IN	PULLED OUT
Sand	Water	140'	155'	8 5/8"	205'	None

Describe in detail the manner in which the well was plugged, indicating where the mud fluid was placed and the method or methods used in introducing it into the hole. If cement or other plugs were used, state the character of same and depth placed, from feet to feet for each plug set.

Filled hole with mud to 600', cement plug 20 sacks through drill pipe. Filled hole to 180', 1/2 sack hulls, 20 sacks cement. Filled hole with mud to 40', 1/2 sack hulls, 10 sacks cement to surface.

RECEIVED
STATE CORPORATION COMMISSION

JUL 25 1962

(Well Log attached.)

CONSERVATION DIVISION
Wichita, Kansas

(If additional description is necessary, use BACK of this sheet)

Name of Plugging Contractor Barnett Drilling, Inc.
Address 409 First Nat'l Bank Bldg., Wichita, Kansas

STATE OF Kansas, COUNTY OF Sedgwick, ss.
James G. Gould, a partner (employee or owner or operator) of the above-described well, being first duly sworn on oath, says: That I have knowledge of the facts, statements, and matters herein contained and the log of the above-described well as filed and that the same are true and correct. So help me God.

(Signature) James G. Gould
411 First Nat'l Bank Bldg., Wichita, Kansas
(Address)

SUBSCRIBED AND SWORN TO before me this 24th day of July, 1962.

Mildred F. Willis
Notary Public.

My commission expires February 27, 1964.



15-135-19097-0000

BARNETT OIL COMPANY
WELL LOG - ELMORE WELL NO. 1
C NE/4 SE/4 SECTION 20-17S-25W
NESS COUNTY, KANSAS

<u>From</u>	<u>To</u>	<u>Formation</u>
0	140	Shale and Shells
140	155	Sand
155	985	Shale and Shells
985	1015	Sand
1015	1210	Shale
1210	1315	Sandy Shale
1315	1791	Shale
1791	1825	Anhydrite
1825	2200	Shale
2200	2460	Shale and Lime Shells
2460	2600	Shale and Lime
2600	2730	Lime
2730	2976	Lime and Shale
2976	3290	Shale and Lime
3290	3740	Lime and Shale
3740	4175	Lime
4175	4325	Lime and Shale
4325	4451	Lime (T.D.) (D. & A.)

Set 8 5/8", 21# used casing
@ 205' with 150 sacks.

RECEIVED
STATE CORPORATION COMMISSION

JUL 25 1962

CONSERVATION DIVISION
Wichita, Kansas