

15-135-30171-00-00


Give All Information Completely  
Make Required Affidavit  
Mail or Deliver Report to:  
Conservation Division  
State Corporation Commission  
211 No. Broadway  
Wichita, Kansas

WELL PLUGGING RECORD

Ness County, Sec. 12 Twp. 17S Rge. 21 (EX) (W)

Location as "NE/CNWSW" or footage from lines C SE/4 NW/4  
Lease Owner National Cooperative Refinery Association  
Lease Name Meehan Well No. 1  
Office Address P. O. Box 6, Great Bend, Kansas  
Character of Well (completed as Oil, Gas or Dry Hole) Dry Hole  
Date well completed February 2 19 66  
Application for plugging filed February 2 (verbal) 19 66  
Application for plugging approved February 2 (verbal) 19 66  
Plugging commenced February 2 19 66  
Plugging completed February 2 19 66  
Reason for abandonment of well or producing formation Dry Hole

NORTH

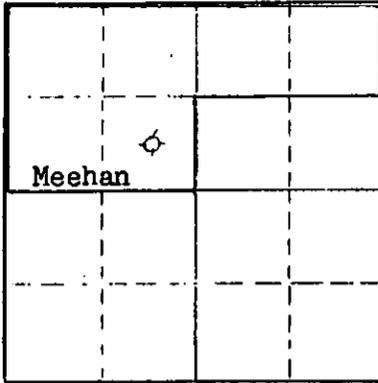

Locate well correctly on above  
Section Plat

If a producing well is abandoned, date of last production 19  
Was permission obtained from the Conservation Division or its agents before plugging was com-  
menced? Yes

Name of Conservation Agent who supervised plugging of this well Gilbert Leiker  
Producing formation \_\_\_\_\_ Depth to top \_\_\_\_\_ Bottom \_\_\_\_\_ Total Depth of Well 4125 Feet  
Show depth and thickness of all water, oil and gas formations.

OIL, GAS OR WATER RECORDS

CASING RECORD

FORMATION	CONTENT	FROM	TO	PIPE SIZE	PUT IN	PULLED OUT

RECEIVED  
FEB 10 1966  
CONSERVATION DIVISION  
Wichita, Kansas

Describe in detail the manner in which the well was plugged, indicating where the mud fluid was placed and the method or methods used in introducing it into the hole. If cement or other plugs were used, state the character of same and depth placed, from \_\_\_\_\_ feet to \_\_\_\_\_ feet for each plug set.

Filled hole with mud - pumped rubber plug to 540' with 20 sacks cement on top. Pumped rubber plug to 375' with 20 sacks cement on top. Pumped rubber plug to 40'. Spotted one-half sack cottonseed hulls on top of plug with 10 sacks cement on top of hulls to surface. Mud was placed between rubber plugs.

Hole plugged @ 9:00 P.M. - February 2, 1966.

(If additional description is necessary, use BACK of this sheet)  
Name of Plugging Contractor Omega Drilling, Inc.  
Address 427 Union Center, Wichita, Kansas.

STATE OF KANSAS COUNTY OF BARTON ss.  
W. F. Griffith (employee of owner) of the above-described

well, being first duly sworn on oath, says: That I have knowledge of the facts, statements, and matters herein contained and the log of the above-described well as filed and that the same are true and correct. So help me God.

(Signature) W. F. Griffith  
W. F. GRIFFITH  
P. O. Box 6, Great Bend, Kansas (Address)

SUBSCRIBED AND SWORN TO before me this 9th day of February, 19 66.

My commission expires October 23, 1966. Irene Kelly Marney Notary Public.