

15-135-20115-00-00

Form CP-4

STATE OF KANSAS
STATE CORPORATION COMMISSION


WELL PLUGGING RECORD

Give All Information Completely
Make Required Affidavit
Mail or Deliver Report to:
Conservation Division
State Corporation Commission
211 No. Broadway
Wichita, Kansas

Ness County, Sec. 12 Twp. 17 S. Rge. (E) 21 (W)

Location as "NE/CNW/SW" or footage from lines NE/4 NE/4
Lease Owner National Cooperative Refinery Association
Lease Name Alta Meehan Well No. 3
Office Address P. O. Box 6, Great Bend, Kansas
Character of Well (completed as Oil, Gas or Dry Hole) Dry Hole
Date well completed February 12, 19 68
Application for plugging filed February 12, 19 68
Application for plugging approved February 12, 19 68
Plugging commenced February 12, 19 68
Plugging completed February 12, 19 68
Reason for abandonment of well or producing formation Dry Hole

NORTH

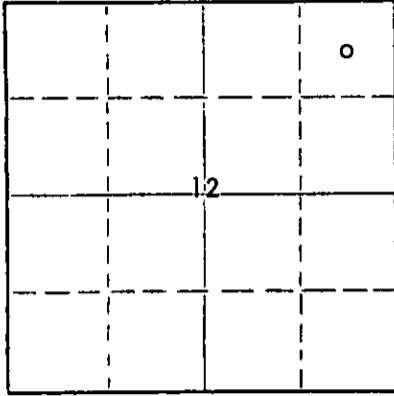

Locate well correctly on above
Section Plat

If a producing well is abandoned, date of last production -- 19
Was permission obtained from the Conservation Division or its agents before plugging was com-
menced? Yes - by phone.

Name of Conservation Agent who supervised plugging of this well Leo Massey
Producing formation _____ Depth to top _____ Bottom _____ Total Depth of Well 4119' Feet
Show depth and thickness of all water, oil and gas formations.

OIL, GAS OR WATER RECORDS

CASING RECORD

FORMATION	CONTENT	FROM	TO	SIZE	PUT IN	PULLED OUT

Describe in detail the manner in which the well was plugged, indicating where the mud fluid was placed and the method or methods used in introducing it into the hole. If cement or other plugs were used, state the character of same and depth placed, from _____ feet to _____ feet for each plug set.

Mudded up to 560'. Set plug of 80 sacks cement.
Mudded up to 40' and filled hole to surface with cement.
Rat hole filled with 2 sacks of cement.

RECEIVED
STATE CORPORATION COMMISSION
FEB 15 1968
CONSERVATION DIVISION
Wichita, Kansas

(If additional description is necessary, use BACK of this sheet)
Name of Plugging Contractor Globe Cementing Company
Address Great Bend, Kansas

02-15-1968

STATE OF Kansas, COUNTY OF Sedgwick, ss.
F. S. Woodside, Jr. agent (employee of owner) of the above-described well, being first duly sworn on oath, says: That I have knowledge of the facts, statements, and matters herein contained and the log of the above-described well as filed and that the same are true and correct. So help me God.

(Signature) F. S. Woodside, Jr.
427 Union Center, Wichita, Kansas 67202
(Address)

SUBSCRIBED AND SWORN TO before me this 13th day of February, 19 68.

My commission expires February 28, 1971

Mary J. Lawrence
Mary J. Lawrence, Notary Public.

15-135-20115-00-00

ROTARY DRILLING LOG

National Cooperative Refinery Association
Meehan #3
NE/4 NE/4 Section 12-17S-21W
Ness County, Kansas

Contractor: Omega Drilling, Inc.
Commenced: February 3, 1968
Completed: February 12, 1968

Casing Record

8 5/8" surface casing cemented
at 402' with 275 sacks.

FORMATIONS

407	Shale and shells
1413	Shale
1446	Anhydrite
2095	Shale
2510	Lime and shale
2595	Lime
3625	Lime and shale
3920	Lime
3962	Lime and sand
4003	Lime
4050	Lime and chert
4098	Chert, lime and shale
4119	Chert and lime
4119	Rotary total depth

We certify that the above log is true and correct to the best of our knowledge and belief.

OMEGA DRILLING, INC.

RECEIVED
STATE CORPORATION COMMISSION
FEB 15 1968
CONSERVATION DIVISION
Wichita, Kansas

By F. S. Woodside, Jr.
President

02-15-1968

Subscribed and sworn to before me, a Notary Public in and for the State of Kansas, County of Sedgwick, this 14th day of February, 1968.

Mary L. Lawrence
Mary L. Lawrence, Notary Public

My commission expires February 28, 1971.