

WELL PLUGGING RECORD

Give All Information Completely
Make Required Affidavit
Mail or Deliver Report to:
Conservation Division
State Corporation Commission
212 No. Market
Wichita, Kansas

Ness County, Sec. 12 Twp. 17S Rge. (E) 21 (W)

Location as "NE/CNW/SW" or footage from lines C SW NW

Lease Owner Tilco, et al

Lease Name Meehan Well No. 1

Office Address 815 Wichita Plaza

Character of Well (completed as Oil, Gas or Dry Hole) Dry Hole

Date well completed 4-18 19 69

Application for plugging filed 4-18 19 69

Application for plugging approved 4-18 19 69


Plugging commenced 4-18 19 69

Plugging completed 4-18 19 69

Reason for abandonment of well or producing formation Dry Hole

If a producing well is abandoned, date of last production 19

Was permission obtained from the Conservation Division or its agents before plugging was commenced? Yes

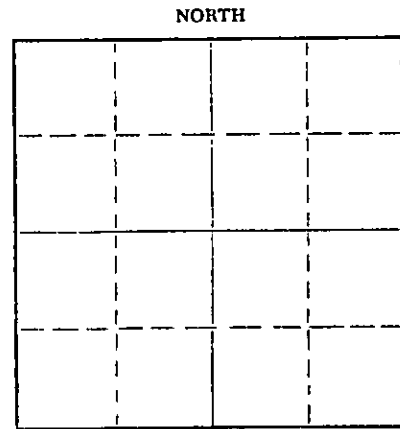

Locate well correctly on above Section Plat

Name of Conservation Agent who supervised plugging of this well Leo Massey

Producing formation Depth to top Bottom Total Depth of Well 4136 Feet

Show depth and thickness of all water, oil and gas formations.

OIL, GAS OR WATER RECORDS

CASING RECORD

FORMATION	CONTENT	FROM	TO	SIZE	PUT IN	PULLED OUT
				8 5/8"	411	None

Describe in detail the manner in which the well was plugged, indicating where the mud fluid was placed and the method or methods used in introducing it into the hole. If cement or other plugs were used, state the character of same and depth placed, from feet to feet for each plug set.

Cemented with 130 sacks 50/50 Posmix 6% gel thru 8 5/8" swedge

RECEIVED
STATE CORPORATION COMMISSION
APR 22 1969
CONSERVATION DIVISION
Wichita, Kansas

04-22-1969

(If additional description is necessary, use BACK of this sheet)

Name of Plugging Contractor

Address

STATE OF KANSAS, COUNTY OF BARTON, ss. Leslie Kite (employee of owner) or (owner or operator) of the above-described well, being first duly sworn on oath, says: That I have knowledge of the facts, statements, and matters herein contained and the log of the above-described well as filed and that the same are true and correct. So help me God.

(Signature) Leslie Kite

SUBSCRIBED AND SWORN TO before me this 21st day of April, 19 69

My commission expires April 1, 1971

(Address) Ulanda Nichols
Notary Public.

15-135-20233-00-00

DRILLER'S LOG

COMPANY	Tilco, et al
CONTRACTOR	LEBEN DRILLING, INC.
FARM	MEEHAN #1
LOCATION	C SW NW SECTION 12-17S-21W NESS COUNTY, KANSAS
COMMENCED	4-9-69
COMPLETED	4-18-69

0	40	Clay
40	260	Shale, Sand
260	411	Shale
411	900	Shale, Shells
900	1100	Sand
1100	1372	Red Bed
1372	1442	Shale
1442	1475	Anhydrite
1475	1575	Shale, Shells
1575	1975	Shale
1975	2030	Shale, Lime
2030	2345	Lime, Shale
2345	2574	Lime
2574	2800	Lime, Shale
2800	2956	Lime
2956	3162	Shale, Lime
3162	3615	Lime, Shale
3615	4113	Lime
4113	4136	Miss Chert
	<u>4136</u>	<u>RTD</u>

RECEIVED
STATE CORPORATION COMMISSION
APR 22 1969
CONSERVATION DIVISION
Wichita, Kansas
04-22-1969

8 5/8" 20# new surface casing set @ 411' cemented with 250 sacks Common cement, 2% cc


I, Leslie Kite, do hereby certify that the above and foregoing is a true and correct copy of the log of the Meehan #1 Well, located C SW NW of Section 12, Township 17 South, Range 21 West, Ness County, Kansas, as reflected by the records of Leben Drilling, Inc.



Leslie Kite

STATE OF KANSAS)
) SS
COUNTY OF BARTON)

Subscribed and sworn to and before me, a Notary Public, in and for Barton County, Kansas, this 21st day of April, 1969.

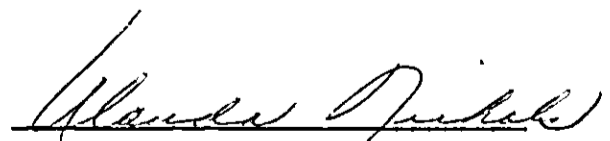

Ulanda Nichols

My Commission Expires:
April 1, 1971