

NOTICE OF INTENTION TO DRILL

(see rules on reverse side)

Starting Date 12 - 15 - 85
 month day year

OPERATOR: License # 5363
 Name BEREXCO INC.
 Address 970 Fourth Financial Center
 City/State/Zip Wichita, KS 67202
 Contact Person Don Beauchamp
 Phone (316)265-3311

CONTRACTOR: License # 5147
 Name Beredco, Inc
 City/State Wichita, KS

Well Drilled For:	Well Class:	Type Equipment:
<input checked="" type="checkbox"/> Oil <input type="checkbox"/> SWD <input type="checkbox"/> Infield <input checked="" type="checkbox"/> Mud Rotary		
<input type="checkbox"/> Gas <input type="checkbox"/> Inj <input type="checkbox"/> Pool Ext. <input type="checkbox"/> Air Rotary		
<input type="checkbox"/> OWWO <input type="checkbox"/> Expl <input checked="" type="checkbox"/> Wildcat <input type="checkbox"/> Cable		

If OWWO: old well info as follows:

Operator
 Well Name
 Comp Date Old Total Depth.....

I certify that well will comply with K.S.A. 55-101, et seq., plus eventually plugging hole to KCC specifications.

..... cementing will be done immediately upon setting production casing
 Date .. 11-5-85 Signature of Operator or Agent *Don Beauchamp* Title..... Geologist.....

For KCC Use:

Conductor Pipe Required feet; Minimum Surface Pipe Required feet per Alt. 1 2
 This Authorization Expires .. 5-12-86 Approved By .. 11-12-85

API Number 15- *135-22,970-00-00*
5W
 NE NE Sec. 3 Twp. 16S S. Rg. 21W East
~~NE NE~~ *4290* West
 990 Ft. from Line of Section
 Ft. from Line of Section

(Note: Locate well on Section Plat on reverse side)

* Note - Irregular Section.
 Nearest lease or unit boundary line 330 feet
 County Ness
 Lease Name Rase Well # 1
 Ground surface elevation 2330 feet MSL
 Domestic well within 330 feet: yes no
 Municipal well within one mile: yes no
 Surface pipe by Alternate: 1 2
 Depth to bottom of fresh water 18'
 Depth to bottom of usable water 750
 Surface pipe planned to be set 350
 Projected Total Depth 4300 feet
 Formation... Mississippian.....

Res/Port


Must be filed with the K.C.C. five (5) days prior to commencing well
This card void if drilling not started within six (6) months of date received by K.C.C.

Important procedures to follow:

1. Notify District office before setting surface casing.
2. Set surface casing by circulating cement to the top.
3. File completion forms ACO-1 with K.C.C. within 90 days of well completion, following instructions on ACO-1, side 1, and including copies of wireline logs.
4. Notify District office 48 hours prior to old well workover or re-entry.
5. Prior to filing Intent, prepare a proposed plugging plan in case well is D & A, then obtain approval of plan when calling district office prior to setting surface pipe.
6. Submit plugging report (CP-4) to K.C.C. after plugging is completed.
7. Obtain an approved injection docket number before disposing of salt water.
8. Notify K.C.C. within 10 days when injection commences or terminates.

A Regular Section of Land
1 Mile = 5,280 Ft.

Irregular Section

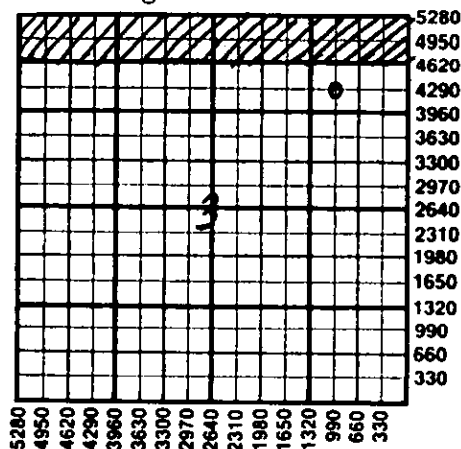

RECEIVED If an alternate 2 completion, cement in the production pipe from
STATE CORPORATION COMMISSION by usable water to surface within 120 days of spud date.

NOV 12 1985
11-12-1985
CONSERVATION DIVISION
Wichita, Kansas

State Corporation Commission of Kansas
Conservation Division
200 Colorado Derby Building
Wichita, Kansas 67202
(316) 263-3236