

CARD MUST BE TYPED

State of Kansas

CARD MUST BE SIGNED

# NOTICE OF INTENTION TO DRILL

(see rules on reverse side)

Starting Date 10 / 15 / 87  
month day year

API Number 15-101-21,423-00-00

OPERATOR: License # 7245  
Name Texas-El Dorado Oil Co. & (Morris C & G)  
Address 550 W. Central, Suite 1108  
City/State/Zip Wichita, KS 67203  
Contact Person K. Wiese  
Phone (316)263-6853

NW SW SW Sec. 31 Twp. 19 S, Rg. 28 East X West  
990 Ft. from South Line of Section  
2310 Ft. from East Line of Section

(Note: Locate well on Section Plat on reverse side)

CONTRACTOR: License # 5420  
Name White & Ellis Drilling  
City/State Wichita, KS

Nearest lease or unit boundary line 330 feet  
County Lane  
Lease Name Atterbury Well # 1-31  
Ground surface elevation 2807 feet MSL  
Domestic well within 330 feet: no X yes  
Municipal well within one mile: no X yes  
Depth to bottom of fresh water 120'  
Depth to bottom of usable water 1250'  
Surface pipe by Alternate: 1 2 X  
Surface pipe planned to be set 280  
Conductor pipe required HR  
Projected Total Depth 4750 feet  
Formation Mississippian

Well Drilled For: Well Class: Type Equipment:  
X Oil SWD Infield X Mud Rotary  
Gas Inj Pool Ext. Air Rotary  
OWWO Expl X Wildcat Cable

If OWWO: old well info as follows:

Operator  
Well Name  
Comp Date Old Total Depth

I certify that well will comply with K.S.A. 55-101, et seq., plus eventually plugging hole to KCC specifications.

Date 28 Sep 87 Signature of Operator or Agent [Signature] Title

For KCC Use:

Conductor Pipe Required \_\_\_\_\_ feet; Minimum Surface Pipe Required 200 feet per Alt. X (2)

This Authorization Expires 3-28-88 Approved By R.H. 9-28-87


EFFECTIVE DATE: 10-2-87

Must be filed with the K.C.C. five (5) days prior to commencing well  
This card void if drilling not started within six (6) months of date received by K.C.C.

Rec'd  
09-28-1987

A Regular Section of Land  
1 Mile = 5,280 Ft.

28 W

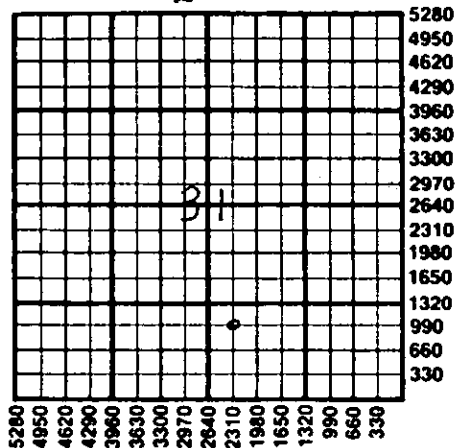

19 S

Important procedures to follow:

1. Notify District office before setting surface casing.
2. Set surface casing by circulating cement to the top.
3. File completion forms ACO-1 with K.C.C. within 90 days of well completion, following instructions on ACO-1, side 1, and including copies of wireline logs.
4. Notify District office 48 hours prior to old well workover or re-entry.
5. Prior to filing Intent, prepare a proposed plugging plan in case well is D & A, then obtain approval of plan when calling district office prior to setting surface pipe.
6. Submit plugging report (CP-4) to K.C.C. after plugging is completed.
7. Obtain an approved injection docket number before disposing of salt water.
8. Notify K.C.C. within 10 days when injection commences or terminates.
9. If an alternate 2 completion, cement in the production pipe from below any usable water to surface within 120 days of spud date.

State Corporation Commission of Kansas  
Conservation Division  
200 Colorado Derby Building  
Wichita, Kansas 67202  
(316) 263-3238