

CARD MUST BE TYPED

State of Kansas

CARD MUST BE SIGNED

NOTICE OF INTENTION TO DRILL

(see rules on reverse side)

Starting Date 5/01/86 month day year

API Number 15-135-23,024-00-00

OPERATOR: License # 4767 Name Ritchie Exploration, Inc. Address 125 N. Market, Suite 1000 City/State/Zip Wichita, Kansas 67202 Contact Person Leah Ann Kasten Phone 316/267-4375

NW SW NE Sec. 33 Twp. 16 S, Rg. 22 East West 3630 Ft. from South Line of Section 2310 Ft. from East Line of Section

(Note: Locate well on Section Plat on reverse side)

CONTRACTOR: License # 6033 Name Murfin Drilling Co City/State Wichita, Kansas

Nearest lease or unit boundary line 330 feet County Ness Lease Name Allen Miller Well # 1

Well Drilled For: Well Class: Type Equipment: X Oil SWD Infield X Mud Rotary Gas Inj Pool Ext Air Rotary OWWO Expl X Wildcat Cable

Ground surface elevation 2412 feet MSL Domestic well within 330 feet: yes X no Municipal well within one mile: yes X no

If OWWO: old well info as follows: Operator Well Name Comp Date Old Total Depth

Depth to bottom of fresh water 50 Depth to bottom of usable water 780-1020 Surface pipe by Alternate: 1 2 X Surface pipe planned to be set 200 Conductor pipe required Projected Total Depth 4450 feet Formation Cherokee

I certify that well will comply with K.S.A. 55-101, et seq., plus eventually plugging hole to KCC specifications.

Date 4/18/86 Signature of Operator or Agent Leah Ann Kasten Title Geologist


For KCC Use: Conductor Pipe Required feet; Minimum Surface Pipe Required 200 feet per Alt 4(2) This Authorization Expires 10-21-86 Approved By 4-21-86 RCH/10/86

Must be filed with the K.C.C. five (5) days prior to commencing well  
This card void if drilling not started within six (6) months of date received by K.C.C.

**Important procedures to follow:**

1. Notify District office before setting surface casing.
2. Set surface casing by circulating cement to the top.
3. File completion forms ACO-1 with K.C.C. within 90 days of well completion, following instructions on ACO-1, side 1, and including copies of wireline logs.
4. Notify District office 48 hours prior to old well workover or re-entry.
5. Prior to filing Intent, prepare a proposed plugging plan in case well is D & A, then obtain approval of plan when calling district office prior to setting surface pipe.
6. Submit plugging report (CP-4) to K.C.C. after plugging is completed.
7. Obtain an approved injection docket number before disposing of salt water.
8. Notify K.C.C. within 10 days when injection commences or terminates.
9. If an alternate 2 completion, cement in the production pipe from below any usable water to surface within 120 days of spud date.

**A Regular Section of Land**  
**1 Mile = 5,280 Ft.**

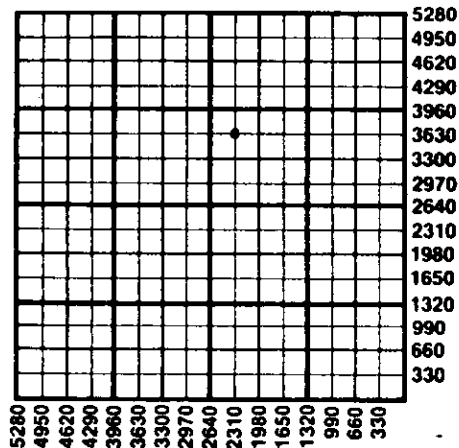

RECEIVED  
STATE CORPORATION COMMISSION

APR 21 1986  
04-21-1986  
CONSERVATION DIVISION  
Wichita, Kansas

State Corporation Commission of Kansas  
Conservation Division  
200 Colorado Derby Building  
Wichita, Kansas 67202  
(316) 263-3238