

CARD MUST BE TYPED

State of Kansas
NOTICE OF INTENTION TO DRILL

CARD MUST BE SIGNED

(see rules on reverse side)

Starting Date: 11 24 85
month day year

API Number IS- 135-22,966-00-00

OPERATOR: License # 5198

SW SW SE Sec 32 Twp 16 S, Rge 22 East West
(location)

Name A. Scott Ritchie

Address 125 N. Market, Suite 950

City/State/Zip Wichita, KS 67202

Contact Person Leah Ann Kasten

Phone (316)267-4375

330 Ft North from Southeast Corner of Section

2310 Ft West from Southeast Corner of Section

(Note: Locate well on Section Plat on reverse side)

CONTRACTOR: License # 6033

Name Murfin Drilling Co.

City/State Wichita, KS

Nearest lease or unit boundary line 330 feet.

County Ness

Lease Name Klitzke 32-D Well# 1

Domestic well within 330 feet: yes no

Municipal well within one mile: yes no

Well Drilled For: Well Class: Type Equipment:
 Oil Swd Infield Mud Rotary
 Gas Inj Pool Ext. Air Rotary
 OWWO Expl Wildcat Cable

Depth to Bottom of fresh water 50 feet

Lowest usable water formation Dakota

Depth to Bottom of usable water ~~750~~ 800 feet

Surface pipe by Alternate: 1 2

Surface pipe to be set 200 feet

Conductor pipe if any required feet

Ground surface elevation est. 2388 feet MSL

This Authorization Expires 5-6-86

Approved By 11-6-85

If OWWO: old well info as follows:
Operator
Well Name
Comp Date Old Total Depth
Projected Total Depth 4475 feet
Projected Formation at TD Mississippi
Expected Producing Formations Cherokee

I certify that we will comply with K.S.A. 55-101, et seq., plus eventually plugging hole to K.C.C. specifications.


Date 11/05/85 Signature of Operator or Agent Leah Ann Kasten Title

Geologist *[Signature]*

Must be filed with the K.C.C. five (5) days prior to commencing well
This card void if drilling not started within six (6) months of date received by K.C.C.

Important procedures to follow:

**A Regular Section of Land
1 Mile = 5,280 Ft.**

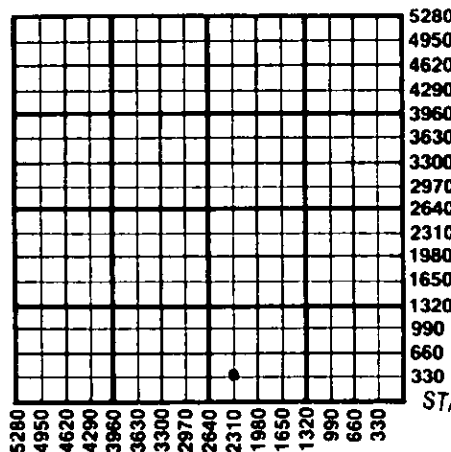

1. Notify District office before setting surface casing.
2. Set surface casing by circulating cement to the top.
3. File completion forms ACO-1 with K.C.C. within 90 days of well completion, following instructions on ACO-1, side 1, and including copies of wireline logs.
4. Notify District office 48 hours prior to old well workover or re-entry.
5. Prior to plugging, prepare a plugging plan, then obtain agreement from the appropriate district office for an approved plugging plan.
6. Submit plugging report (CP-4) to K.C.C. after plugging is completed.
7. Obtain an approved injection docket number before disposing of salt water.
8. Notify K.C.C. within 10 days when injection commences or terminates.
9. If an alternate 2 completion, cement in the production pipe from below the possible water to surface within 120 days of spud date.

RECEIVED
STATE CORPORATION COMMISSION

NOV 6 1985
11-06-1985
CONSERVATION DIVISION
Wichita, Kansas

State Corporation Commission of Kansas
Conservation Division
200 Colorado Derby Building
Wichita, Kansas 67202
(316) 263-3238