

CARD MUST BE TYPED

State of Kansas  
NOTICE OF INTENTION TO DRILL

CARD MUST BE SIGNED

(see rules on reverse side)

Starting Date: ..... 12 ..... 12 ..... 84 .....  
month day year

API Number 15- 135-22,725-00-00

OPERATOR: License # 5399

NE.. NE.. ... Sec 23.. Twp 16.. S, Rge 21W.  East  
(location)  West

Name American Energies Corporation

Address 575 Fourth Financial Center

City/State/Zip Wichita, Kansas 67202

Contact Person Martha Albright

Phone (316) 263-5785

.4620..... Ft North from Southeast Corner of Section

.660..... Ft West from Southeast Corner of Section

(Note: Locate well on Section Plat on reverse side)

CONTRACTOR: License # 5131

Nearest lease or unit boundary line .660..... feet.

Name Thunderbird Drilling, Inc.

County Ness.....

City/State Wichita, Kansas

Lease Name Skaggs..... Well# "A" #1...

Well Drilled For: Well Class: Type Equipment:

Oil  Swd  Infield  Mud Rotary

Gas  Inj  Pool Ext.  Air Rotary

OWWO  Expl  Wildcat  Cable

Domestic well within 330 feet:  yes  no

Municipal well within one mile:  yes  no

If OWWO: old well info as follows:

Operator .....

Well Name .....

Comp Date ..... Old Total Depth .....

Projected Total Depth 4200..... feet

Projected Formation at TD Mississippian.....

Expected Producing Formations Cherokee.....

Depth to Bottom of fresh water 180..... feet

Lowest usable water formation ..... Dakota.....

Depth to Bottom of usable water 180' 550'..... feet

Surface pipe by Alternate: 1 2 3.....

Surface pipe to be set 300..... feet

Conductor pipe if any required ..... feet

Ground surface elevation N/A..... feet MSI.

This Authorization Expires 5-13-85.....

Approved By 11-13-84.....

I certify that we will comply with K.S.A. 55-101, et seq., plus eventually plugging hole to K.C.C. specifications.

Date 11/12/84..... Signature of Operator or Agent

Alan L. DeGood

Title Vice-President

Alan L. DeGood

m HC/KOHE 11/13/84


Must be filed with the K.C.C. five (5) days prior to commencing well  
This card void if drilling not started within six (6) months of date received by K.C.C.

10/20/84  
10/20/84  
10/20/84

11-13-1984

**Important procedures to follow:**

**A Regular Section of Land**  
**1 Mile = 5,280 Ft.**

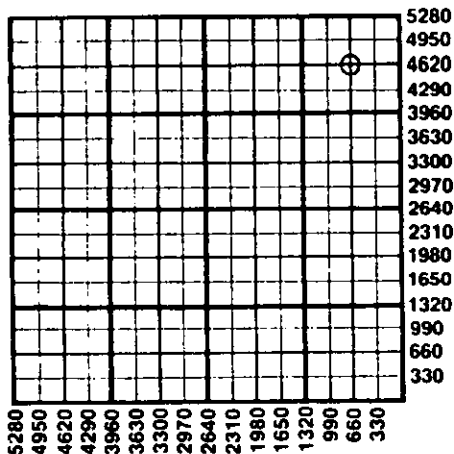

1. Notify District office before setting surface casing.
2. Set surface casing by circulating cement to the top.
3. File completion forms ACO-1 with K.C.C. within 90 days of well completion, following instructions on ACO-1, side 1, and including copies of wireline logs.
4. Notify District office 48 hours prior to old well workover or re-entry.
5. Prior to plugging, prepare a plugging plan, then obtain agreement from the appropriate district office for an approved plugging plan.
6. Submit plugging report (CP-4) to K.C.C. after plugging is completed.
7. Obtain an approved injection docket number before disposing of salt water.
8. Notify K.C.C. within 10 days when injection commences or terminates.
9. If an alternate 2 completion, cement in the production pipe from below any usable water to surface within 120 days of spud date.

**State Corporation Commission of Kansas**  
**Conservation Division**  
**200 Colorado Derby Building**  
**Wichita, Kansas 67202**  
**(316) 263-3238**