

FOR KCC USE:

FORM C-1 7/91

EFFECTIVE DATE: 9-4-91

FORM MUST BE TYPED

DISTRICT #

State of Kansas

FORM MUST BE SIGNED

SEA? Yes  No

NOTICE OF INTENTION TO DRILL

ALL BLANKS MUST BE FILLED

Must be approved by the K.C.C. five (5) days prior to commencing well

Expected Spud Date 8 month 31 day 91 year

Spot SW SW NW Sec 30 Twp 16 S. Rg 21 East West

OPERATOR: License # 6040 Name: Bankoff Oil Company Address: Box 700657 City/State/Zip: Tulsa, OK 74170 Contact Person: Frank Mize Phone: (316) 262-2784

2970' feet from South / North line of Section 4950' feet from East / West line of Section

IS SECTION X REGULAR IRREGULAR?

(NOTE: Locate well on the Section Plat on Reverse Side) County: Ness

CONTRACTOR: License #: 30684 Name: Abercrombie RTD, Inc.

Lease Name: Sunley Well #: #2 Field Name: unknown

Is this a Prorated/Spaced Field? yes X no

Target Formation(s): Mississippi 330' Nearest lease or unit boundary: unknown

Ground Surface Elevation: unknown feet MSL Water well within one-quarter mile: yes X no

Well Drilled For: Well Class: Type Equipment: X Oil Enh Rec Infield X Mud Rotary Gas Storage X Pool Ext Air Rotary OWWO Disposal Wildcat Cable Seismic: # of Holes Other

Public water supply well within one mile: yes X no

Depth to bottom of fresh water: 180' Depth to bottom of usable water: 700'

Surface Pipe by Alternate: 1 X 2

Length of Surface Pipe Planned to be set: 250'

Length of Conductor pipe required: None

Projected Total Depth: 4400' Formation at Total Depth: Miss.

Water Source for Drilling Operations: X well farm pond other

If OWWO: old well information as follows:

DWR Permit #: Will file

Will Cores Be Taken?: yes X no

If yes, proposed zone: N/A

Operator: N/A

Well Name:

Comp. Date: Old Total Depth

Directional, Deviated or Horizontal wellbore? yes X no

If yes, true vertical depth: Bottom Hole Location: N/A

AFFIDAVIT

The undersigned hereby affirms that the drilling, completion and eventual plugging of this well will comply with K.S.A. 55-101, et. seq.

It is agreed that the following minimum requirements will be met:

- 1. Notify the appropriate district office prior to spudding of well;
2. A copy of the approved notice of intent to drill shall be posted on each drilling rig;
3. The minimum amount of surface pipe as specified below shall be set by circulating cement to the top; in all cases surface pipe shall be set through all unconsolidated materials plus a minimum of 20 feet into the underlying formation;
4. If the well is dry hole, an agreement between the operator and the district office on plug length and placement is necessary prior to plugging;
5. The appropriate district office will be notified before well is either plugged or production casing is cemented in;
6. IF AN ALTERNATE II COMPLETION, PRODUCTION PIPE SHALL BE CEMENTED FROM BELOW ANY USABLE WATER TO SURFACE WITHIN 120 DAYS OF SPUD DATE. IN ALL CASES, NOTIFY DISTRICT OFFICE PRIOR TO ANY CEMENTING.

I hereby certify that the statements made herein are true and to the best of my knowledge and belief.

Date: 8-29-91 Signature of Operator or Agent: [Signature] Title: Executive Vice President

FOR KCC USE: API # 15- 135-23,600-00-00 Conductor pipe required n/a feet Minimum surface pipe required 200 feet per Alt. (2) Approved by: [Signature] 8-30-91 This authorization expires: 2-29-92 (This authorization void if drilling not started within 6 months of effective date.) Spud date: Agent:

08-30-1991

RECEIVED STATE OF KANSAS CONSERVATION DIVISION WICHITA, KANSAS AUG 30 1991

320 16 21W

REMEMBER TO:

- File Drill Pit Application (form CDP-1) with Intent to Drill;
- File Completion Form ACO-1 within 120 days of spud date;
- File acreage attribution plat according to field proration orders;
- Notify appropriate district office 48 hours prior to workover or re-entry;
- Submit plugging report (CP-4) after plugging is completed;
- Obtain written approval before disposing or injecting salt water.

Mail to: Conservation Division, 200 Colorado Derby Building, 202 W. First St., Wichita, Kansas 67202-1286.

IN ALL CASES PLOT THE INTENDED WELL ON THE PLAT BELOW  
PLAT OF ACREAGE ATTRIBUTABLE TO A WELL IN A PRORATED OR SPACED FIELD

If the intended well is in a prorated or spaced field, please fully complete this side of the form. If the intended well is in a prorated or spaced field complete the plat below showing that the well will be properly located in relationship to other wells producing from the common source of supply. Please show all the wells within 1 mile of the boundaries of the proposed acreage attribution unit for gas wells and within 1/2 mile of the boundaries of the proposed acreage attribution unit for oil wells.

API NO. 15- \_\_\_\_\_  
 OPERATOR Bankoff Oil Company  
 LEASE Sunley  
 WELL NUMBER #2  
 FIELD unknown

LOCATION OF WELL: COUNTY Ness  
 2970' feet from south/north line of section  
 4950' feet from east/west line of section  
 SECTION 30 TWP 16S RG 21

NUMBER OF ACRES ATTRIBUTABLE TO WELL \_\_\_\_\_  
 QTR/QTR/QTR OF ACREAGE SW - SW - NW

IS SECTION X REGULAR or \_\_\_\_\_ IRREGULAR  
 IF SECTION IS IRREGULAR, LOCATE WELL FROM NEAREST CORNER BOUNDARY.



Section corner used: \_\_\_\_\_ NE \_\_\_\_\_ NW \_\_\_\_\_ SE \_\_\_\_\_ SW

**PLAT**

(Show location of the well and shade attributable acreage for prorated or spaced wells.)

(Show footage to the nearest lease or unit boundary line.)

**R 21 W**

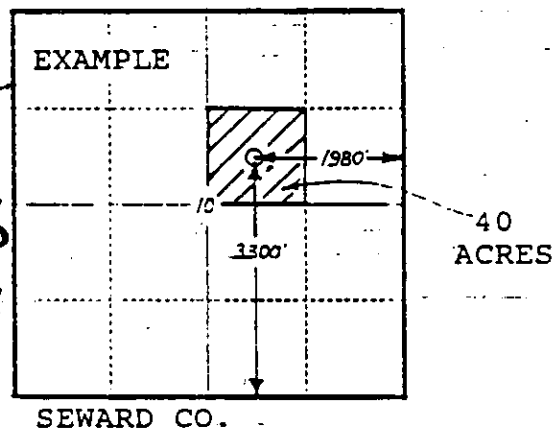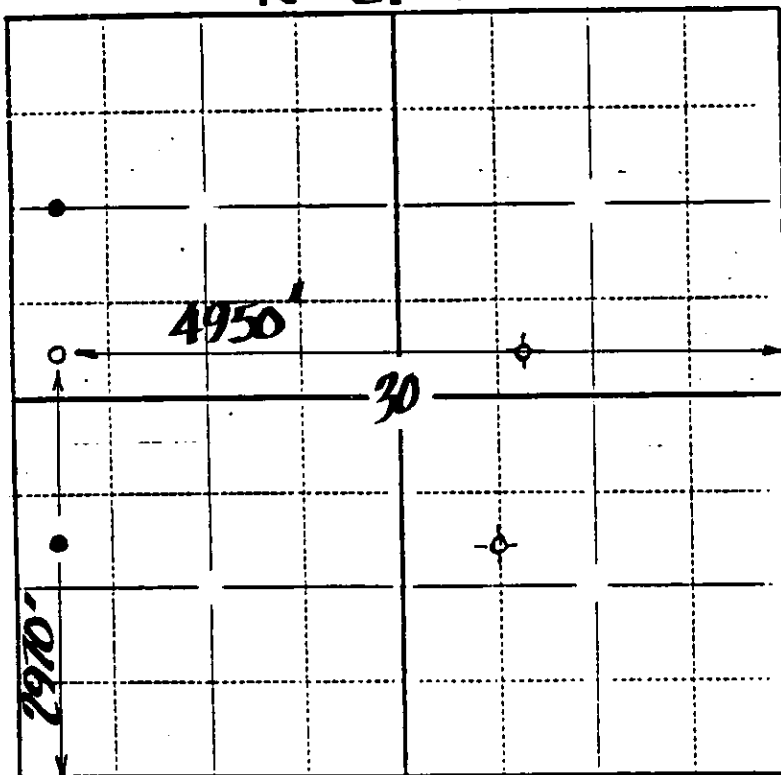

In plotting the proposed location of the well, you must show:

- 1) The manner in which you are using the depicted plat by identifying section lines, i.e. 1 section, 1 section with 8 surrounding sections, 4 sections, etc.;
- 2) the distance of the proposed drilling location from the section's south/north and east/west lines; and
- 3) the distance to the nearest lease or unit boundary line.