

CARD MUST BE TYPED

State of Kansas
NOTICE OF INTENTION TO DRILL
(see rules on reverse side)

CARD MUST BE SIGNED

Starting Date: July 8 1985
month day year

API Number IS- 135-22,861-00-00

OPERATOR: License # 5399

Name American Energies Corporation

Address 575 Fourth Financial Center

City/State/Zip Wichita, Kansas 67202

Contact Person Martha C. Albright

Phone (316) 263-5785

NW SE NE Sec 29 Twp 16 S Rge 21W East
(location) West

3630 Ft North from Southeast Corner of Section

990 Ft West from Southeast Corner of Section
(Note: Locate well on Section Plat on reverse side)

CONTRACTOR: License # 5422

Name Abercrombie Drilling, Inc.

City/State Wichita, Kansas

Nearest lease or unit boundary line 990 feet.
County Ness

Lease Name Hiltabidle "A" Well# 1

Domestic well within 330 feet: yes no

Municipal well within one mile: yes no

Well Drilled For: Well Class: Type Equipment:

XX Oil Swd Infield Mud Rotary

Gas Inj Pool Ext. Air Rotary

OWWO Expl Wildcat Cable

Depth to Bottom of fresh water 180 feet

Lowest usable water formation Dakota

Depth to Bottom of usable water 550 feet

Surface pipe by Alternate: 1 2

Surface pipe to be set 650 feet

Conductor pipe if any required N/A feet

Ground surface elevation feet MSL

This Authorization Expires 1-1-86

Approved By 2-1-85 RCH for KONE

If OWWO: old well info as follows:

Operator

Well Name

Comp Date Old Total Depth

Projected Total Depth 4300' feet

Projected Formation at TD Mississippi

Expected Producing Formations Cherokee

I certify that we will comply with K.S.A. 55-101, et seq., plus eventually plugging hole to K.C.C. specifications.

Date 6/26/85 Signature of Operator or Agent


Alan L. DeGood
Alan L. DeGood

Title Vice-President

Must be filed with the K.C.C. five (5) days prior to commencing well
This card void if drilling not started within six (6) months of date received by K.C.C.

Rec'd
07-01-1985

A Regular Section of Land
1 Mile = 5,280 Ft./

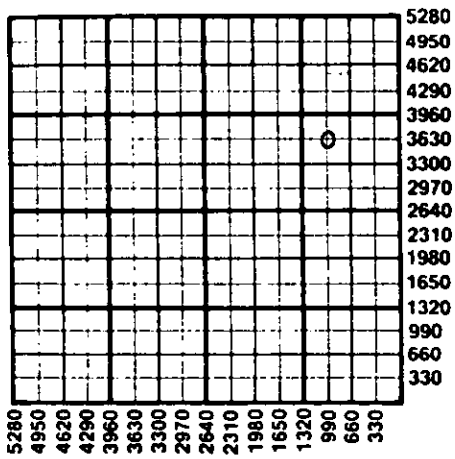

Important procedures to follow :

1. Notify District office before setting surface casing.
2. Set surface casing by circulating cement to the top.
3. File completion forms ACO-1 with K.C.C. within 90 days of well completion, following instructions on ACO-1, side 1, and including copies of wireline logs.
4. Notify District office 48 hours prior to old well workover or re-entry.
5. Prior to plugging, prepare a plugging plan, then obtain agreement from the appropriate district office for an approved plugging plan.
6. Submit plugging report (CP-4) to K.C.C. after plugging is completed.
7. Obtain an approved injection docket number before disposing of salt water.
8. Notify K.C.C. within 10 days when injection commences or terminates.
9. If an alternate 2 completion, cement in the production pipe from below any usable water to surface within 120 days of spud date.

State Corporation Commission of Kansas
Conservation Division
200 Colorado Derby Building
Wichita, Kansas 67202
(316) 263-3238