


CARD MUST BE SIGNED

API Number 15- 135-22,720-00-00

100' E. C. SE. NW. Sec 18. Twp 16. S, Rge 24. ☒ West

..3300..... Ft North from Southeast Corner of Section
 ..3150..... Ft West from Southeast Corner of Section
 (Note: Locate well on Section Plat on reverse side)

Nearest lease or unit boundary line 510 feet.
County ... Ness
Lease Name Evel Well# 1
Domestic well within 330 feet : ☐ yes ☒ no
Municipal well within one mile : ☐ yes ☒ no

Depth to Bottom of fresh water 90 feet
 Lowest usable water formation Dakota
 Depth to Bottom of usable water 900 feet
 Surface pipe by Alternate : 1 ☐ 2 ☒
 Surface pipe to be set 280 feet
 Conductor pipe if any required None feet
 Ground surface elevation 2483 feet MSL
 This Authorization Expires 5-8-85
 Approved By 11-8-84 

Date 11-7-84 Signature of Operator or Agent [Signature]

Pat Raymond


Title Vice President.....

77HC/KONE 11/8/84 Form C-1 4/84

Must be filed with the K.C.C. five (5) days prior to commencing well
This card void if drilling not started within six (6) months of date received by K.C.C.

Important procedures to follow :

**A Regular Section of Land
1 Mile = 5,280 Ft.**

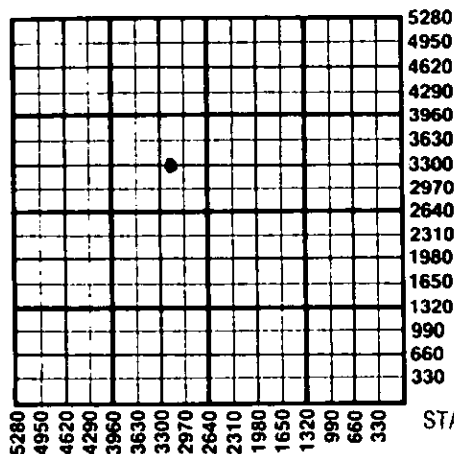

1. Notify District office before setting surface casing.
2. Set surface casing by circulating cement to the top.
3. File completion forms ACO-1 with K.C.C. within 90 days of well completion, following instructions on ACO-1, side 1, and including copies of wireline logs.
4. Notify District office 48 hours prior to old well workover or re-entry.
5. Prior to plugging, prepare a plugging plan, then obtain agreement from the appropriate district office for an approved plugging plan.
6. Submit plugging report (CP-4) to K.C.C. after plugging is completed.
7. Obtain an approved injection docket number before disposing of salt water.
8. Notify K.C.C. within 10 days when injection commences or terminates.
9. If an alternate 2 completion, cement in the production pipe from below any usable water to surface within 120 days of spud date.

RECEIVED

STATE CORPORATION COMMISSION

State Corporation Commission of Kansas

Conservation Division

200 Colorado Derby Building

Wichita, Kansas 67202

(316) 263-3238

NOV 08 1984

11-08-1984

CONSERVATION DIVISION

Wichita, Kansas